CODE ADMINISTRATION PLANS

ADD: 4418 WYOMING BLVD. N.E.

DES: REMODEL

D 24 C 20 B 16 A 12

CONSTRUCTION ADDRESS 4418 Wyoming Blvd. N.E.

CITY OF ALBUQUERQUE
CODE ADMINISTRATION DIVISION

Note: Final Inspections are required on all permitted work whether a certificate of occupancy is required or not.

APPLICANT TO PROVIDE ALL INFORMATION BELOW:

TYPE OF APPLICATION:
- ☐ NEW BUILDING
- ☐ ADDITION
- ☒ ALTERATION
- ☐ REPAIR
- ☐ DEMOLITION
- ☐ OTHER

CITY OF ALBUQUERQUE CODE ADMINISTRATION DIVISION RECEIVED SEP 29 1992 U&C PLAN CHECK SECTION

LEGAL DESCRIPTION:
LOT NO. 1 BLOCK NO. ____
SUBDIVISION Clifford-Mullins Business Addition
TRACT ____ PARCEL ____ UNIT ____

OWNER: Spring Valley Investment Inc. PHONE: 505-822-3010
ADDRESS: 4418 Wyoming NE
Albuquerque NM ZIP: 87111

ARCHITECT, ENGINEER OR DESIGNER: Burson and Williams PHONE: 214-871-8774
ADDRESS: 2615 Stutz Street
Dallas Texas ZIP: 75204

CONTRACTOR: Hart Driven & Const. Inc PHONE: 260-0238
ADDRESS: 1320 Princeton NE
Albuq. NM ZIP: 87106

STATE LICENSE NO. 30124
STATE TAX NO. 02 132 610 000
CITY TAX NO. 02 132 610 000 01

CONSTRUCTION DATA:
NUMBER OF STORIES: 1
SQUARE FOOTAGE: 10,000
VALUATION OF WORK: $ 50,000
NO. OF APT/MOTEL UNITS n/a
NO. OF BUILDINGS 1
OWNERSHIP: ☐ PRIVATE ☐ PUBLIC
DESCRIPTION OF WORK: Remodel Minor interior Remodel

BUILDING USE:
- ☐ PUBLIC (BUILT WITH PUBLIC FUNDS)
- ☒ COMMERCIAL
- ☐ TRIPLEX
- ☐ FOURPLEX
- ☐ APARTMENT COMPLEX GREATER THAN FOUR UNITS
- ☐ FOUNDATION ONLY

DATE 12-11-92

Plan Check (Application) No. 9212194
Plan Check (Application) Fee $ 177.45 Adjusted $ ____
Valuation of Work $ 50,000.00
Building Permit No. 9212194
Building Permit Fee $ 273.00

Certificate of Occupancy Required? ☐ Yes ☒ No

Approval Required Prior to Issuance of Certificate of Occupancy:

City Agency	Yes or No	Initial	Date
ENVIRONMENTAL HEALTH	Yes	BS	10-14
FIRE MARSHAL			
HYDROLOGY			
MECHANICAL			
PLUMBING			
ELECTRICAL			
HEIGHT			
ELEVATOR			
REFUSE			
TRANSPORTATION DEVELOPMENT			
UNIFORM BUILDING CODE	No	WM	12-14-92
ZONING	MO	JH	10/6/92

CITY ENGINEER

Address based on information furnished by Requestee
Date 10/8/92

Provide ☐ 4' ☐ 6' sidewalk set to ☐ curb ☐ property

In accordance with Sidewalk Ordinance Existing By [signature]

Uniform Property Code: 1-020-060-037-505-2-31-17

GENERAL NOTES

1. Plans and specifications must be kept at building or work site at all times during which the work authorized thereby is in progress.
2. City approved street and alley top of curb elevations shall be used when establishing lot grades at front and rear property lines. Should these approved elevations not be used, the City assumes no responsibility for loss of access to property or damage to property line walls upon construction of street and alley curb-gutter- paving.
3. Separate permits are required for plumbing, gas and electrical work.
4. The issuance of this building permit does not constitute a guarantee of water and sanitary sewer service. Such availability is determined by the Engineering Division, Public Works Department, Utility Development Division. 505-768-2775 Construction hydrant shall be placed at least 10 feet away from watermeter.
5. Gates in walls or fences on private or public property shall not swing over sidewalk, street, alley or public right of way.
6. Separate sign, wall and fence permits are required.
7. For foundation only permits additional plans must be submitted for approval before plumbing or electrical work is started in building slab. Include Uniform Building Code construction type on submittal.

ZONING:
1. Pave and appropriately mark parking spaces per City standards (Refuse bins may not be placed in required spaces). Alley must be paved per City standards before final inspection. Area and parking area lighting must be fixed per City standard, off-site luminance shall not be greater than 1000 footlamberts; it shall not be greater than 200 footlamberts measured from private property in a residential zone.
2. Solar Protection - all construction on this site shall be in compliance with the solar regulations of the City Zoning Code. The City approval of this document is not assurance that its contents conform with any private solar rights which may be recorded with the Bernalillo County Clerk.

UNIFORM BUILDING CODE:
1. In every residential sleeping room, one window with 5.7 S.F. net clear openable area with minimum net clear opening height of 24", minimum net clear opening width of 20", and finished sill height not more than 44" above the floor is required.
2. Exhaust fans and/or vents to be connected directly to the outside.
3. Finishes to comply with UBC Table 42B.
4. Pre-fab fireplaces must have listed manufacturers installation instructions at the job site, UBC Sec. 3707 (a).
5. All labeled doors to have labeled frames and closers UBC Sec. 4306 (b).
6. Door glazing to comply with Federal Standard 16 CFR-1201. Fixed panel glazing to comply with Chapter 54, UBC.
7. Suspended Ceiling Framing Systems to Comply with Table 23-J. See UBC Standard 47.1812 (c).
8. All openings & fixtures in rated ceilings to be protected per UBC or approved tests.
9. Where walls require protected openings, pipe penetrations and electrical outlet box installations shall comply with UBC Sec. 4304 (e).
10. Regardless of the occupant load, there shall be a floor or landing on each side of a door. The floor or landing shall be not more than 1/2 inch lower than the threshold of the doorway. UBC Sec. 3304 (h).
11. Landings at doors shall have a width not less than the width of the door. Landings shall have a length measured in the direction of travel of not less than 44 inches. UBC Sec. 3304 (i).

UNIFORM PLUMBING, MECHANICAL, ELECTRICAL CODES:
1. Water heaters, heating and cooling equipment generating a glow or flame capable of igniting flammable vapors may be installed in a residential garage, provided the pilots and burners or heating elements and switches are at least eighteen (18) inches above the floor level.
2. Materials exposed within circulating air ducts in other than dwelling units shall have a flamespread rating of not more than 25 and a smoke developed rating of not more than 50.
3. Provide ground fault protection on all bathroom, garage and exterior electrical outlets.
4. Pool placement shall conform to Section 680-8 NEC and Section 351-C-1 NESC.
5. Do not locate building under power line.
6. Sanitary facilities must be provided on each construction job.

ENVIRONMENTAL HEALTH
1. All remodels for all food service establishments, swimming pools, and other projects related to Environmental Health must be submitted to Environmental Health for Review. Contact Environmental Health, Phone (505) 764-1693 to determine if project is related to Environmental Health.
2. Permit for demolition of structures in excess of 75,000 cubic feet shall be obtained from Environmental Health.

1. ZONING / REFUSE

505- 764-1670

city zone C-2 zoning map C-20 s/a ____ lot ____ acreage ____
use Turkish Remodel Only

Municipal Refuse Collection Ordinance 42-1980

Notes:
1. Caution on location of structure: City approval is contingent upon correct information being received from the contractor or owner. Zoning approval is given for a structure sited exactly as specified on these plans. The front setback is measured from the lot line, which is not necessarily the curb or the edge of the sidwalk.
2. # ____ Park Development Fee (Park Dedication and Development Ordinance No. 7-1976, Article XVIII, Chapter 7, Sections 3A. and 3B., CR 461611-721300).
3. The Albuquerque Refuse Service should be contacted at least (30) days prior to occupancy to start service.
4. Each customer shall provide their own container(s).
5. This building(s) is required to have a final inspection by the Refuse Division. The refuse container required shall be in place prior to the Certificate of Occupancy being issued.
6. Inspection required before pouring concrete slab or apron by the Albuquerque Refuse Department.

Proposed construction complies with Albuquerque Comprehensive Zoning Ordinance, and the Albuquerque Municipal Refuse Collection Ordinance.

NAME

PLANS DISAPPROVED ____ DATE ____
PLANS APPROVED [signature] DATE 10/6/92

PLANS CORRECTIONS REQUIRED:

(INDICATE CONSTRUCTION ORDINANCE SECTION REFERENCE)

2. HYDROLOGY

505- 764-1699 ; 768-2650

Notes: 1. Advise Drainage Inspector when grading is executed.
2. Any deletions or modifications to approved drainage plans must receive prior approval from City Hydrology prior to final inspection.

NAME

PLANS DISAPPROVED ____ DATE ____
PLANS APPROVED ____ DATE ____

PLAN CORRECTIONS REQUIRED:

(INDICATE CONSTRUCTION ORDINANCE SECTION REFERENCE)

BUILDING PLANS REJECTED FOR THE FOLLOWING REASONS :

( ) Drainage Report/Plan required for original construction and modifications and/or additions to existing structures of 500 square feet or more. See Section 12 B of the City's Drainage Ordinance.
NOTE: Recommend a pre-design meeting with this office prior to putting pen to paper, please contact this office for an appointment.

( ) Follow procedures for drainage submittals outlined in Page 101, Sec. 22.7 volume 2 of the City's Development Process Manual.

( ) Attach copies of the approved Drainage Plan/Report to the Building Plans.

( ) Attach signed copies of the "Private Storm Drain Facilities within City Right-of-Way" document to the Building Plans.

( ) Pending approval of Drainage Plan/Report submitted.

FLOOD HAZARD ORDINANCE CERTIFICATION

☐ This site is in flood hazard zone ____ (COMMENT: ____)

☐ The improvements must be in compliance with city ordinance 99-1981.
The flood plain elevation is ____.
The finish floor elevation shall be ____.
Separate Certification shall be required by the City Engineer prior to final inspection (call 766-7644).

☐ OTHER: ____

☐ APPROVED: ____ ☐ DISAPPROVED: ____

NOTE: Separate certification form may be obtained from the City Engineer's office upon request.

3. TRANSPORTATION DEVELOPMENT

505- 764-1646 ; 768-2680

- ☐ Overwidth curb cut
- ☐ Underwidth curb cut
- ☐ Too near corner
- ☐ Insufficient standing curb
- ☐ No curb cuts shown
- ☐ Insufficient Set Back
- ☐ Too near property line

NAME

PLANS DISAPPROVED ____ DATE ____
PLANS APPROVED ____ DATE ____

PLAN CORRECTIONS REQUIRED:

(INDICATE CONSTRUCTION ORDINANCE SECTION REFERENCE)

4. ENVIRONMENTAL HEALTH

505- 764-1693

Notes: 1. Control dust and debris during construction.
2. Top soil disturbance permit: Required ☐ Not Required ☒
Top soil permit issued by ____ Date ____
3. Noise ordinance is applicable.

NAME

PLANS DISAPPROVED ____ DATE ____
PLANS APPROVED [signature] DATE 10-14-92

PLAN CORRECTIONS REQUIRED:

(INDICATE CONSTRUCTION ORDINANCE SECTION REFERENCE)

5. FIRE MARSHAL

505- 764-1687

Notes 1. All apartment, commercial and public buildings are required to have a final inspection by the Fire Marshal's Office before a certificate of occupancy is issued. The building(s) or space(s) shall be complete and ready to occupy.
2. Conditions, surrounding and arrangements to be in accordance with the Fire Prevention code regulations adopted by City ordinance.
3. All items listed below shall be installed in accordance with applicable fire codes prior to a building (or portion of a building) being occupied. In addition, an approved adequate water supply shall be provided before any combustible materials are delivered to the building site and all required fire hydrants shall be installed and operable before any building (or portion of the building) is occupied.

NAME OF BUSINESS [illegible] STORE OR SPACE # ____
OCCUPANCY: [illegible]
BUILDING PLANS FOR: NEW ☐ REMODEL EXISTING ☐ ADDITION ☐
CONSTRUCTION TYPE ____
FIRE FLOW REQUIRED ____ FIRE HYDRANTS REQUIRED ____ ATLAS PAGE # ____

NAME (INSPECTOR)

PLANS DISAPPROVED ____ DATE ____
PLANS APPROVED [signature] DATE 10 13 92

PLANS CORRECTIONS REQUIRED:

(INDICATE CONSTRUCTION ORDINANCE SECTION REFERENCE)

6. UNIFORM BUILDING CODE

505- 764-1677

Notes:
1. Premises shall not be occupied until a Certificate of Occupancy has been issued, in accordance with Sec. 308, Albuquerque Uniform Administrative Code.
2. All windows and doors required to meet forced entry requirements shall bear identification indicating they conform to Ch. 41 of the New Mexico Uniform Building Code.

Description of Work Restaurant remodel
Size of Bldg. (total) Sq. Ft. 10000 Occupancy Group A-3
Type of Construction III (1hr.) Year of Applicable UBC 1988

NAME Spring Valley

PLANS DISAPPROVED Donald G Bartlett DATE 10.6.92
PLANS APPROVED [signature] DATE 10.13.92

PLANS CORRECTIONS REQUIRED:

(INDICATE CONSTRUCTION ORDINANCE SECTION REFERENCE)

1. ~~Sign existing~~ Stamp on front sht.
2. Provide Code data (See stamp on front sht.)
3. [redacted]

Plan review to continue regarding Const. type

7. UPC, UMC, NEC.

505- 764-1680

Notes:
1. Every Furnace or water heater room shall have an opening or door and passageway thereto not less than 2 feet in width and large enough to permit removal of the largest furnace in such room. The furnace shall be installed so as to permit its removal without disturbing the piping or conduit and appurtenant valves or junction boxes.

NAME

PLANS DISAPPROVED ____ DATE ____
PLANS APPROVED [signature] DATE 10/6/92

PLANS CORRECTIONS REQUIRED:

(INDICATE CONSTRUCTION ORDINANCE SECTION REFERENCE)

CITY OF ALBUQUERQUE

CITY CLERK RECORDER

OFFICIAL SEAL
NORETTA SANCHEZ
NOTARY PUBLIC
STATE OF NEW MEXICO
My Commission Expires May 6, 1995

This microimage is certified to be a complete and accurate copy of the original as it was received in the CODE ADMINISTRATION DIVISION and was filmed in the normal course of business.

The photographic process used meets the standards of the National Micrographics Association (AIIM 15-1977).

IM #440 DATE 6/4/93 BY SP

THIS MICROIMAGE IS THE BEST POSSIBLE REPRODUCTION DUE TO THE POOR QUALITY OF THE ORIGINAL DOCUMENT.

CITY OF ALBUQUERQUE

C

D

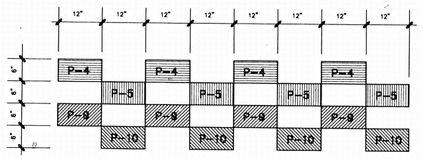

REFER TO PAINT SCHEDULE FOR PAINT SPECIFICATIONS AND COLOR

05 TYPICAL EXTERIOR CHECKERBOARD

SCALE: 3/4" = 1'-0"

WARNING/DISCLAIMER

ARCHITECTS, CONTRACTORS AND BUILDING OWNERS MUST COMPLY WITH THE AMERICANS WITH DISABILITIES ACT (ADA) AND THE AMERICANS WITH DISABILITIES (ARCHITECTURAL GUIDELINES (ADAAG). THE CODE ADMINISTRATION DIVISION FOR THE CITY OF ALBUQUERQUE DOES NOT REVIEW WITHIN PLANS AND SPECIFICATIONS COMPLY WITH THE ADA. **THE ISSUANCE OF A BUILDING PERMIT AND COMPLIANCE WITH THE CODES DOES NOT INSURE COMPLIANCE WITH THE ADA OR ADAAG.** THE REVIEWED BUILDING OWNER AND CONTRACTOR MAY WAIT TO COMPLETE LAWYER CONFERRING THE ADA OR ADAAG. I AM THE OWNER AGENT OR REPRESENTATIVE OF THE BUILDING OWNER OR CONTRACTOR. I HAVE READ AND UNDERSTAND THIS WARNING/DISCLAIMER.

SIGNATURE _____ DATE 10-6-92

CODE INFORMATION

Occupancy Class A-3
Type of Construction 3-H (1)
Area of Each Floor 10000 ☐
Occupant Load 487 (1)
Seismic Zone 2B
Soil Bearing Capacity
Concrete Strength
Stress Values: Lumber _____ Steel _____
Wind Design Load
Roof Design Load
Floor Design Load
Corridor Design Load
Adm. Bldg. Code 301 (d)

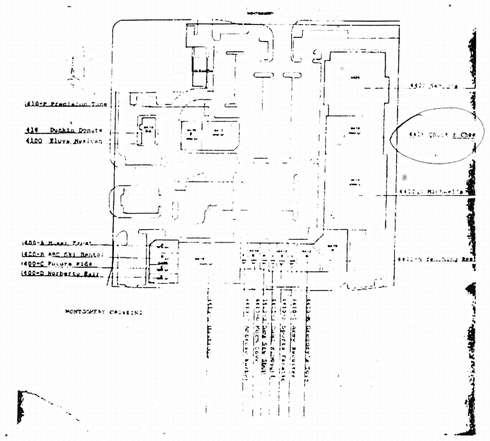

06 SITE PLAN

NO SCALE

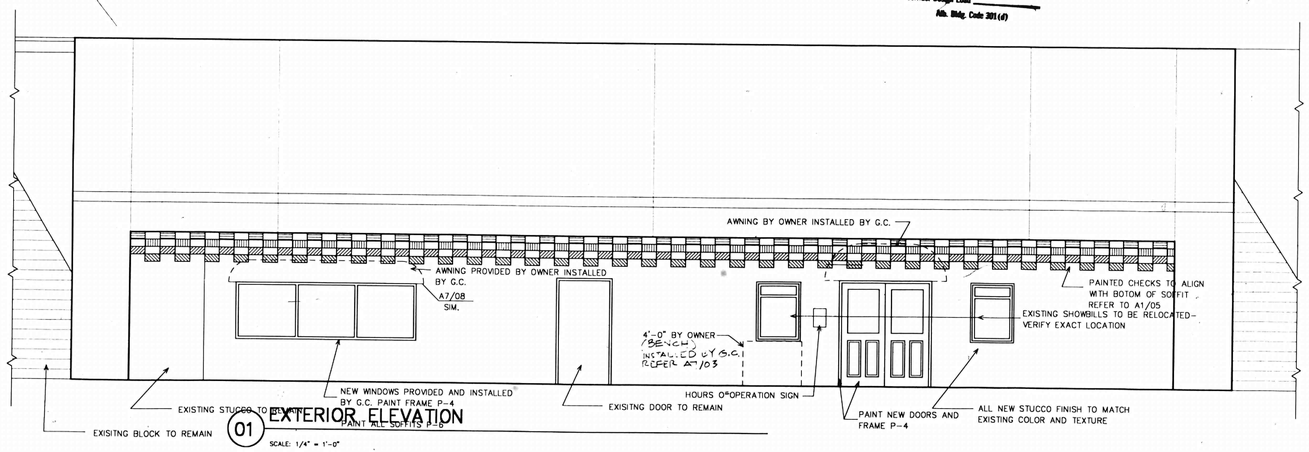

01 EXTERIOR ELEVATION

SCALE: 1/4" = 1'-0"

GENERAL NOTES:

1. All new interior finishes must carry a One Hour Flame Spread rating.
2. All new glazing shall conform to Safety Glazing requirements of applicable building code.
3. Panic hardware must be provided on all exit doors: All exits must be able to be opened from the inside without use of a key or any special knowledge or effort.
4. Lighted exit signs must be provided at each exterior door and as necessary to direct exit travel.
5. All HVAC is existing and no new HVAC equipment is being added.
6. General Contractor is required to meet with ShowBiz Pizza Time, Inc. technician to review games layout and compressed air requirements.
7. General Contractor is to provide and install gypsum board at any area where wall covering has been removed or surface has been damaged.
8. General Contractor is to match the height of existing doors and field verify door sizes and finish before ordering.
9. General Contractor is responsible for painting coin changers and is to have ShowBiz Pizza Time, Inc. technician install new cover before item is painted.
10. General Contractor to match existing finishes, color and texture when matching existing items.
11. General Contractor is to provide temporary lighting in any area where light fixtures have been removed for operations of next day usage.

INDEX OF DRAWINGS

A-1 SITE PLAN & EXTERIOR ELEVATIONS
A-2 DEMOLITION PLAN
A-3 NEW CONSTRUCTION FLOOR PLAN
A-4 INTERIOR ELEVATIONS
A-5 INTERIOR ELEVATIONS
A-6 COUNTERS AND DETAILS
A-7 NOTES AND DETAILS
A-8 NOTES AND SCHEDULES
E-1 ELECTRICAL, GAMES AND SEATING
B-1C ANIMATED DISPLAY

PLANS
ALBUQUERQUE
CODE ADMIN.
OCT 06 1992
U.S.C.
PLAN CHECK
SECTION

PROJECT DATA

PROJECT AREA: 10,000 Sq. Ft.

BUILDING CODE: 1991 UNIFORM BUILDING CODE

C. C. KOEHLER, CONSULTING ARCHITECT, A.I.A.

B&W BURSON AND WILLIAMS ARCHITECTS INC.
3808 Blake Street • Dallas, Texas 75204 • 214/871-9711

STATE OF NEW MEXICO REGISTERED ARCHITECTS CHARLES C. KOEHLER 7663 DALLAS TEXAS

CHUCK E. CHEESE

THESE DOCUMENTS ARE THE SOLE PROPERTY OF SHOWBIZ PIZZA TIME, INC. ANY COPYING OR USE OF THESE DOCUMENTS FOR ANY PURPOSE OTHER THAN CONSTRUCTION OF THIS PROJECT WITHOUT THE EXPRESS WRITTEN PERMISSION OF THE ARCHITECT AND SHOWBIZ PIZZA IS PROHIBITED.

CHUCK E. CHEESE'S PIZZA #3161 – ALBUQUERQUE
4418 WYOMING NE – ALBUQUERQUE, NEW MEXICO – 8711.
SPRING VALLEY AMUSEMENT, INC.
5776 ARROWHEAD DRIVE • SUITE 108
VIRGINIA BEACH, VIRGINIA 23462

EXTERIOR ELEVATION

Date
04 AUGUST 1992

Revisions
⚠ 30 SEPT 1992

Project Number
92-090

Sheet Number
A1
of 8

THIS PLAN SHOT TWICE
ONCE ON LIGHT AND
ONCE ON DARK.

CITY OF ALBUQUERQUE
THIS MICROIMAGE IS THE BEST POSSIBLE REPRODUCTION DUE TO THE POOR QUALITY OF THE ORIGINAL DOCUMENT.

REF 440 DATE 6/4/92 OP ESP
CITY OF ALBUQUERQUE
This microimage is certified to be a complete and accurate copy of the original as it appears in the files of the CODE ADMINISTRATION DIVISION and was filmed in the normal course of business.
The photographic processes used meet the Basic Microfilm Standards of the National Micrographics Association (MS115-1977).

Karen Reeves
CITY CLERK RECORDER

OFFICIAL SEAL
NORBERTA SANCHEZ
NOTARY PUBLIC
STATE OF NEW MEXICO
My Commission Expires MAY 6, 1995
Norberta Sanchez

D 24 C 20 B 16 A 12

CITY OF ALBUQUERQUE

C D

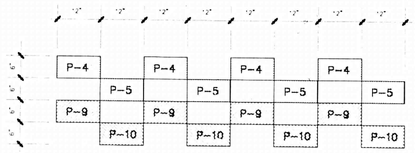

REFER TO PAINT SCHEDULE FOR PAINT SPECIFICATIONS AND COLOR

05 TYPICAL EXTERIOR CHECKERBOARD

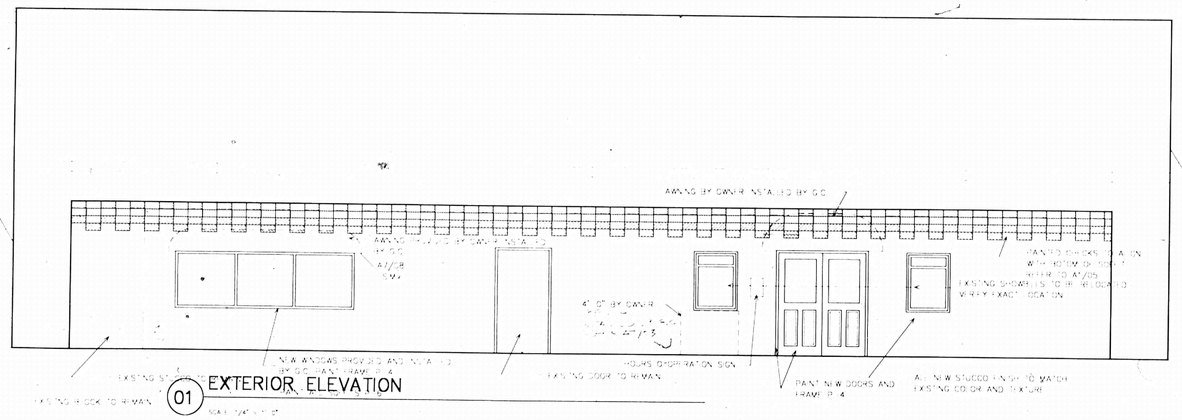

01 EXTERIOR ELEVATION

 

06 SITE PLAN

GENERAL NOTES:

1. All new interior finishes must carry a One Hour Flame Spread rating.
2. All new glazing shall conform to Safety Glazing requirements of applicable building code.
3. Panic hardware must be provided on all exit doors. All exits must be able to be opened from the inside without use of a key or any special knowledge or effort.
4. Lighted exit signs must be provided at each exterior door and as necessary to direct exit travel.
5. All HVAC is existing and no new HVAC equipment is being added.
6. General Contractor is required to meet with ShowBiz Pizza Time, Inc. technician to review games layout and compressed air requirements.
7. General Contractor is to provide and install gypsum board at any area where wall covering has been removed or surface has been damaged.
8. General Contractor is to match the height of existing doors and field verify door sizes and color before ordering.
9. General Contractor is responsible for painting coin chargers and is to have ShowBiz Pizza Time, Inc. technician install new cover before item is painted.
10. General Contractor to match existing finishes, color and texture when matching existing items.
11. General Contractor is to provide temporary lighting in any area where light fixtures have been removed for operations of next day usage.

INDEX OF DRAWINGS

A-1 SITE PLAN & EXTERIOR ELEVATIONS
A-2 DEMOLITION PLAN
A-3 NEW CONSTRUCTION FLOOR PLAN
A-4 INTERIOR ELEVATIONS
A-5 INTERIOR ELEVATIONS
A-6 COUNTERS AND DETAILS
A-7 NOTES AND DETAILS
A-8 NOTES AND SCHEDULES
E-1 ELECTRICAL, GAMES AND SEATING

PROJECT DATA

PROJECT AREA: 10,000 Sq. Ft.
BUILDING CODE: 199 UNIFORM BUILDING CODE

C. C. KOEHLER, CONSULTING ARCHITECT, A.I.A.

B&W BURSON AND WILLIAMS ARCHITECTS INC.
8828 Stemmons Freeway • Dallas, Texas 75247 • 214/631-0996

THESE DOCUMENTS ARE THE SOLE PROPERTY OF SHOWBIZ PIZZA TIME, INC. ANY COPYING OR USE OF THESE DOCUMENTS FOR ANY PURPOSE OTHER THAN CONSTRUCTION OF THIS PROJECT WITHOUT THE EXPRESS WRITTEN PERMISSION OF THE ARCHITECT AND SHOWBIZ PIZZA IS PROHIBITED.

CHUCK E. CHEESE'S PIZZA #3161 – ALBUQUERQUE
4418 WYOMING NE – ALBUQUERQUE, NEW MEXICO – 87111
SPRING VALLEY AMUSEMENT, INC.
5776 ARROWHEAD DRIVE • SUITE 108
VIRGINIA BEACH, VIRGINIA 23462

EXTERIOR ELEVATION

Date
04 AUGUST 1992

Revisions
1 SEPT 92

Project Number
92-090

Sheet Number
A1
of 8

CITY OF ALBUQUERQUE

This microimage is certified to be a complete and accurate copy of the original as it appears in the files of the CODE ADMINISTRATION DIVISION and was filmed in the normal course of business. The photographic processes used meet the Basic Microfilm Standards of the National Micrographics Association (NMS115-1977).

CITY CLERK RECORDER

OFFICIAL SEAL NORBERTA SANCHEZ NOTARY PUBLIC STATE OF NEW MEXICO My Commission Expires May 5, 1995

D 24 C 20 B 16 A 12

CITY OF ALBUQUERQUE

C D

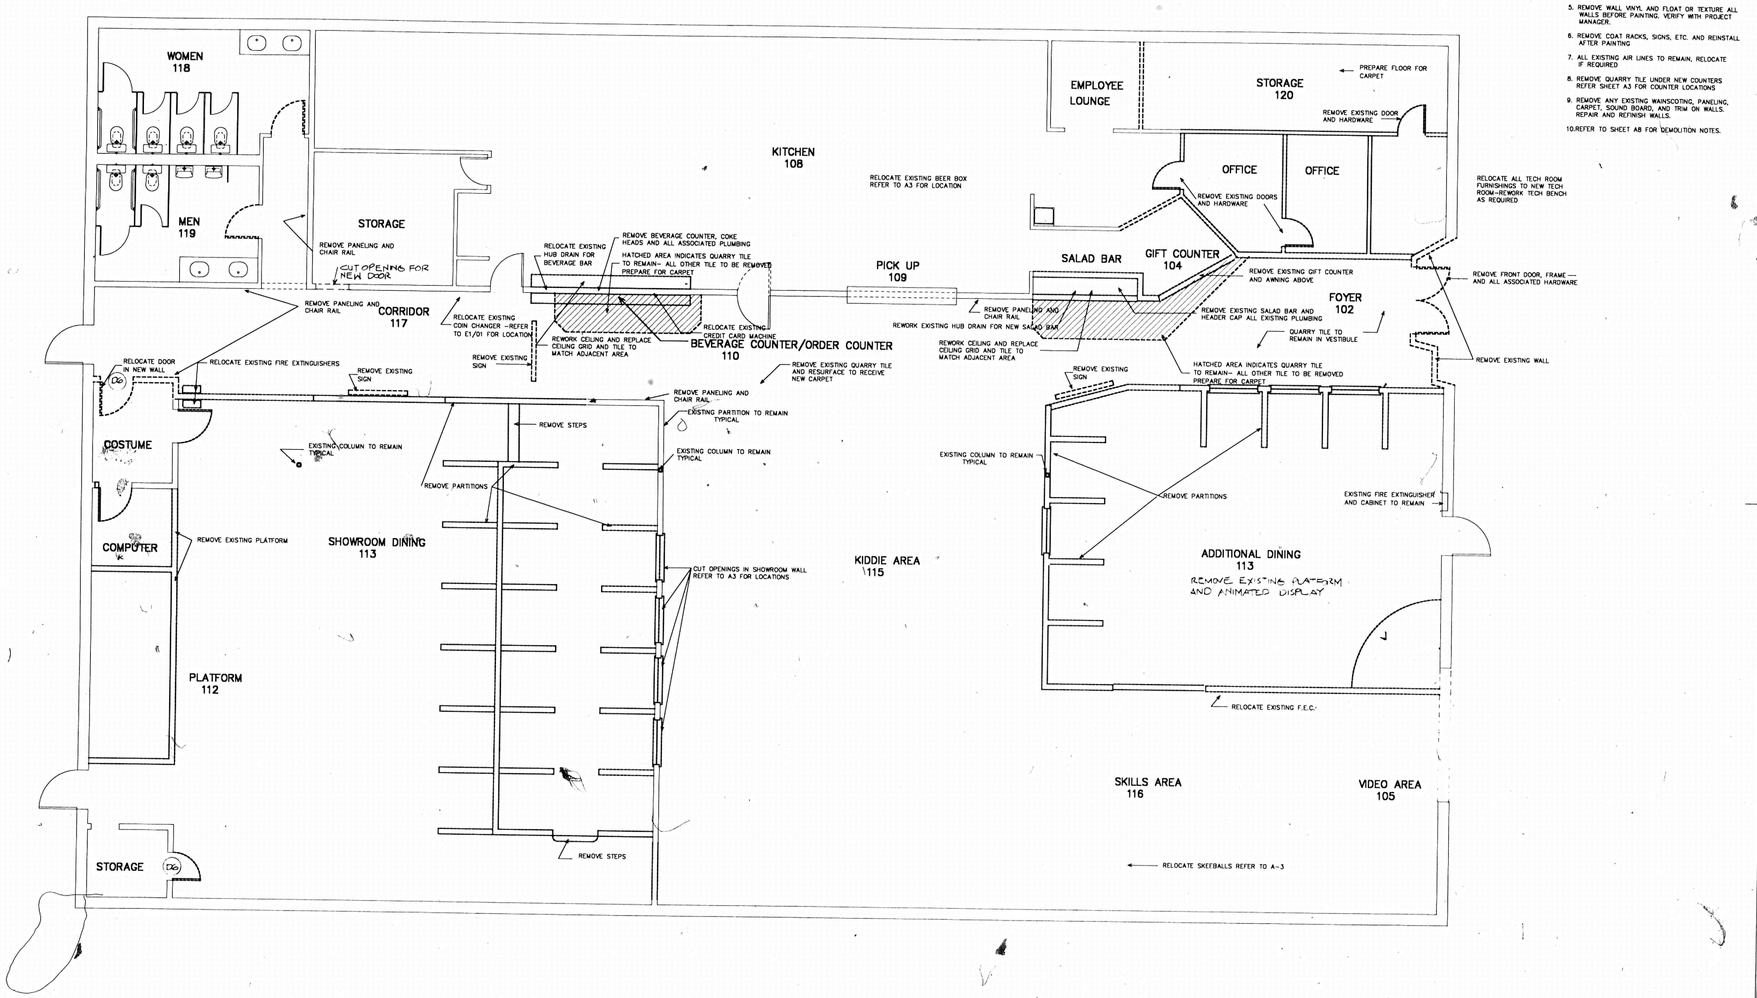

01 DEMOLITION PLAN

SCALE: 3/16" = 1'-0"

C. C. KOECHER, CONSULTING ARCHITECT, A.I.A.

BURSON WILLIAMS ARCHITECTS INC.

800 Palo Duro • Suite, Texas 79064 • 806/372-4771

REGISTERED ARCHITECT STATE OF NEW MEXICO

CHUCK E. CHEESE'S PIZZA

THESE DOCUMENTS ARE THE SOLE PROPERTY OF SHOWBIZ PIZZA TIME, INC. ANY COPYING OR USE OF THESE DOCUMENTS FOR ANY PURPOSE OTHER THAN CONSTRUCTION OF THIS PROJECT WITHOUT THE EXPRESS WRITTEN PERMISSION OF THE ARCHITECT AND SHOWBIZ PIZZA IS PROHIBITED.

CHUCK E. CHEESE'S PIZZA #3161 -- ALBUQUERQUE

4418 WYOMING NE -- ALBUQUERQUE, NEW MEXICO -- 87111

SPRING VALLEY AMUSEMENT, INC.
5757 ARROWHEAD DRIVE * SUITE 108
VIRGINIA BEACH, VIRGINIA 23462

DEMOLITION PLAN

Date
04 AUGUST 1992

Revisions

Project Number
92-090

Sheet Number
A2
of 8

REV 340 DATE 6/4/93 OP ESP

CITY OF ALBUQUERQUE

This microimage is certified to be a complete and accurate copy of the original as it appears in the files of the CLERK ADMINISTRATION DIVISION and was filmed in the normal course of business.
The photographic processes used meet the Basic Microfilm Standards of the National Micrographics Association (MS115-1977).

CITY CLERK RECORDER

OFFICIAL SEAL
NORBERTA SANCHEZ
NOTARY PUBLIC
STATE OF NEW MEXICO
My Commission Expires MAY 5, 1995

Norberta Sanchez

D 24 C 20 B 16 A 12

CITY OF ALBUQUERQUE

C D

BUILDING & SAFETY PLANS 1 of 5

ADD: 4418 WYOMING BLVD. N.E.

DES: REMODEL

ALBUQUERQUE BUILDING & SAFETY
JUL 30 1999
U.B.C. PLAN CHECK SECTION

CONSTRUCTION ADDRESS 4418 Wyoming Blvd NE

CITY OF Albuquerque

CITY OF ALBUQUERQUE WORK ADMINISTRATION ORDINANCE

BUILDING SAFETY DIVISION

APPLICANT TO PROVIDE ALL INFORMATION BELOW:

TYPE OF APPLICATION:
- ☐ NEW BUILDING
- ☐ REPAIR
- ☐ ADDITION
- ☐ DEMOLITION
- ☒ ALTERATION
- ☐ OTHER

CONSTRUCTION DATA:
NUMBER OF STORIES: 1
SQUARE FOOTAGE: 10076
VALUATION OF WORK: $ 125,000
NO. OF APT/MOTEL UNITS
NO. OF BUILDINGS
OWNERSHIP: ☒ PRIVATE ☐ PUBLIC
DESCRIPTION OF WORK: Int Remodel Chuck E Cheese

LEGAL DESCRIPTION:
LOT NO. 4 BLOCK NO.
SUBDIVISION Clifford Mullins Business Addn
TRACT PARCEL UNIT

OWNER: C.E.C. Ent Inc. PHONE: (972) 258-8507
ADDRESS: 4441 W Airport Frwy
Irving TX ZIP: 75062

ARCHITECT, ENGINEER OR DESIGNER: C.T. Chang & Assoc PHONE: (817) 354-6010
ADDRESS: 1010 Eules Blvd Suite 110
Eules TX ZIP: 76040

CONTRACTOR: Parkway Const & Assoc. PHONE: (972) 221-1979
ADDRESS: 1000 Civic Circle
Lewisville TX ZIP: 75067

NM STATE LICENSE NO. 53576
LICENSE CLASSIFICATION
NM STATE TAX NO. 02318951007
ABQ BUSINESS REG. NO. 9885593892

BUILDING USE:
- ☐ PUBLIC (BUILT WITH/PUBLIC FUNDS)
- ☒ COMMERCIAL
- ☐ TRIPLEX
- ☐ FOURPLEX
- ☐ APARTMENT COMPLEX GREATER THAN FOUR UNITS
- ☐ FOUNDATION ONLY

Plan Check (Application) No. 99110386
Plan Check (Application) Fee $ 316.61 Adjusted $
Valuation of Work $ 125,000
Building Permit No. 99110386
Building Permit Fee $ 487.09

G 30

CITY ENGINEER

Address based on information furnished by Requestee
Date 8.6.99

Provide ☐ 4' ☐ curb sidewalk set to ☐ 6' ☐ property

In accordance with Sidewalk Ordinance
n/a By

Uniform Property Code:
n/a

	Yes	No
Certificate of Occupancy Required:	☐	☒
Shell Certificate of Completion Required:	☐	☐

Approval Required Prior to Issuance of Certificate:

City Agency	Yes or No	Initial	Date
ENVIRONMENTAL HEALTH	YES	SH	8.5
FIRE MARSHALL	NO Yes	JCM	8-11 99
HYDROLOGY			
MECHANICAL	No		
PLUMBING	No		
ELECTRICAL	YES		
BOILER	No		
ELEVATOR	No		
REFUSE			
TRANSPORTATION DEVELOPMENT			
UNIFORM BUILDING CODE	No	ACT	8/10/99
ZONING	Yes		8/12/99

Note: Final inspections are required on all permitted work whether a certificate of occupancy is required or not.

GENERAL NOTES

1. Plans and specifications must be kept at building or work site at all time during which the work authorized thereby is in progress.
2. City approved street and alley top of curb elevations shall be used when establishing lot grades at front and rear property lines. Should these approved elevations not be used, the City assumes no responsibility for loss of access to property or damage to property line walls upon construction of street and alley curb-gutter-paving.
3. Separate permits are required for plumbing, gas and electrical work. The issuance of this permit does not guarantee that the permit holder (owner) will receive a certificate of occupancy to occupy the building upon completion of construction. The permit holder has the duty to comply with all the requirements for a certificate of occupancy including, but not limited to, code requirements, water and sanitary sewer service, electrical service and natural gas service.
4. The issuance of this building permit does not constitute a guarantee of water and sanitary sewer service. Such availability is determined by the (Utility Development) Div., Public Works Dept. Construction hydrant shall be placed at least 10 feet away from watermeter.
5. Gates in walls or fences on private or public property shall not swing over sidewalk, street, alley or public right-of-way.
6. Separate sign, wall and fence permits are required.
7. For foundation only permits additional plans must be submitted for approval before plumbing or electrical work is started in building slab. Include Uniform Building Code construction type on submittal.

ZONING:

Solar Protection - all construction on this site shall be in compliance with the solar regulations of the City Zoning Code. The City approval of this document is not assurance that its contents conform with any private solar rights which may be recorded with the Bernalillo County Clerk.

UNIFORM BUILDING CODE:

1. In every residential sleeping room, one window with 5.7 S.F. net clear openable area with minimum net clear opening height of 24", minimum net clear opening width of 20", and finished sill height not more than 44" above the floor is required.
2. Exhaust fans and/or vents to be connected directly to the outside.
3. Finishes to comply with UBC Table 42B.
4. Pre-fab fireplaces must have listed manufacturers installation instructions at the job site, UBC Sec. 3507(e).
5. All labeled doors to have labeled frames and closers UBC Sec. 4306(c).
6. Door glazing to comply with Federal Standard 16 CFR-1201. Fixed panel glazing to comply with Chapter 54, UBC.
7. Suspended Ceiling Framing Systems to Comply with Table 23-P.
8. All openings & fixtures in rated ceilings to be protected per UBC or approved tests.
9. Where walls require protected openings, pipe penetrations and electrical outlet box installations shall comply with UBC Sec. 4304(e).
10. Regardless of the occupant load, there shall be a floor or landing on each side of a door. UBC Sec. 3304(j).

UNIFORM PLUMBING, MECHANICAL, ELECTRICAL CODES:

1. Water heaters, heating and cooling equipment generating a glow or flame capable of igniting flammable vapors may be installed in a residential garage, provided the pilots and burners or heating elements and switches are at least eighteen (18) inches above the floor level.
2. Materials exposed within circulating air ducts in other than dwelling units shall have a flamespred rating of not more than 25 and a smoke developed rating of not more than 50.
3. Provide ground fault protection on all bathroom, garage, kitchen (some) and exterior electrical outlets.
4. Pool placement shall conform to Section 680-8 NEC and Section 351-C-1 NESC.
5. Do not locate building under power line.
6. Sanitary facilities must be provided on each construction job.

WATER WASTE ORDINANCE

1. Landscape irrigation systems shall be designed, installed, and operated to prevent overflow of water onto the public right-of-way or adjacent property. This is required by the City of Albuquerque Water Waste Ordinance (Chapter 8, Article XVI, R.O. 1974).

ENVIRONMENTAL HEALTH

1. All remodels for all food service establishments, swimming pools, and other projects related to Environmental Health must be submitted to Environmental Health for Review. Contact Environmental Health, (505) 924-3623 to determine if project is related to Environmental Health.
2. Permit for demolition of structures in excess of 75,000 cubic feet shall be obtained from Environmental Health.
3. All building construction that requires Air Quality registration or issuance of air quality permit(s) must be submitted to the Environmental Health Department for review. Contact the Albuquerque Environmental Health Department, Air Pollution Control Division, at 768-2600 to determine if this project requires registration or issuance of air quality permit(s).

Food & Beverage Ordinance (Chapter 9, Article 6)	(505) 924 - 3623
Swimming Pool / Spa Ordinance (Chapter 10, Article 10)	(505) 924 - 3623
For noise ordinance (Chapter 9, Article 9)	(505) 768 - 2600
For On-site Liquid Waste Disposal (NMEIB Regulation)	(505) 768 - 2600
For Surface Disturbance/Demolition (20NMAC11.20.II)	(505) 768 - 2639
For Air Quality Impacts/Permits (Chapter 9, Article 5)	(505) 768 - 2600 / 1930

1. ZONING

city zone C2 zoning map G-20 z/za lot acreage
505-924-3840 use Interior Tenant is remodel only

1. CAUTION ON LOCATION OF STRUCTURE: City approval is contingent upon correct information being received from the contractor or owner. Zoning approval is for structures sited exactly as specified on these plans. Setbacks are measured from the lot lines; the lot line at street right of way is not necessarily the curb or edge of sidewalk.

2. $ - Park Development Fee, Park Dedication and Development Ordinance, Sections 14-9-3(A) and (B), ROA 1994.

Proposed construction complies with the Comprehensive City Zoning Code, 14-16 ROA, 1994.

PLANS DISAPPROVED DATE
PLANS APPROVED DATE 8/7/99

PLANS CORRECTIONS REQUIRED: (INDICATE ORDINANCE SECTION REFERENCE)

2. SOLID WASTE DISPOSAL

505-761-8100, ext. 8149

(Sections 9-10-1-1 et seq., Revised Ordinances of Albuquerque, 1994)
1. This building(s) is required to have a final inspection by the Plan Checker of the Solid Waste Management Department (SWMD). The refuse container(s) required shall be in place prior to the Certificate of Occupancy being issued.
2. Inspection by the Plan Checker of the SWMD is required before pouring of the concrete slab or apron.
3. Each customer shall provide their own container(s) as required by the Plan Checker of the SWMD.
4. The Solid Waste Management Department shall be contacted at least thirty (30) days prior to occupancy to start service.
5. Proposed construction complies with the Albuquerque "Municipal Refuse Collection Service Ordinance" (being Ordinance 42-1980, as amended).

PLANS DISAPPROVED DATE
PLANS APPROVED DATE

PLANS CORRECTIONS REQUIRED: (INDICATE ORDINANCE SECTION REFERENCE)

3. HYDROLOGY

(505) 924-3983

Notes: 1. Advise Drainage Inspector when grading is executed.
2. Any deletions or modifications to approved drainage plans must receive prior approval from City Hydrology prior to final inspection.

NAME

PLANS DISAPPROVED DATE
PLANS APPROVED DATE

PLAN CORRECTIONS REQUIRED:

(INDICATE CONSTRUCTION ORDINANCE SECTION REFERENCE)

BUILDING PLANS REJECTED FOR THE FOLLOWING REASONS:

( ) Drainage Report/Plan required for original construction and modifications and/or additions to existing structures of 500 square feet or more. See Section 12 B of the City's Drainage Ordinance.
NOTE: Recommend a pre-design meeting with this office prior to putting pen to paper, please contact this office for an appointment.

( ) Follow procedures for drainage submittals outlined in Page 101, Sec. 22.7 volume 2 of the City's Development Process Manual.

( ) Attach copies of the approved Drainage Plan/Report to the Building Plans.

( ) Attach signed copies of the "Private Storm Drain Facilities within City Right-of-Way" document to the Building Plans.

( ) Pending approval of Drainage Plan/Report submitted.

FLOOD HAZARD ORDINANCE CERTIFICATION

☐ This site is in flood hazard zone (COMMENT:)

☐ The improvements must be in compliance with city ordinance 99-1981.
The flood plain elevation is .
The finish floor elevation shall be .
Separate Certification shall be required by the City Engineer prior to final.

☐ OTHER:

☐ APPROVED: ☐ DISAPPROVED:

NOTE: Separate certification form may be obtained from the City Engineer's office upon request.

4. TRANSPORTATION DEVELOPMENT

(505) 924-3991

3 DAYS ADVANCE NOTICE IS REQ'D FOR SITE INSPECTIONS.

Plans Disapproved Date
Plans Approved Date

PLAN CORRECTIONS REQUIRED:
(INDICATE ORDINANCE SECTION REFERENCE)

5. ENVIRONMENTAL HEALTH

(505) 924-3623

Plans Disapproved Date
Plans Approved Date 8.5.99

PLAN CORRECTIONS REQUIRED:
(INDICATE ORDINANCE SECTION REFERENCE)

Under Remodel Only

6. FIRE MARSHAL

(505) 924-3620

Notes 1. All apartment, commercial and public buildings are required to have a final inspection by the Fire Marshal's Office before a certificate of occupancy is issued. The building(s) or space(s) shall be complete and ready to occupy.
2. Conditions, surrounding and arrangements to be in accordance with the Fire Prevention code regulations adopted by City ordinance.
3. All items listed below shall be installed in accordance with applicable fire codes prior to a building (or portion of a building) being occupied. In addition, an approved adequate water supply shall be provided before any combustible materials are delivered to the building site and all required fire hydrants shall be installed and operable before any building (or portion of the building) is occupied.

NAME OF BUSINESS 4418 WYOMING BLVD NE STORE OR SPACE # 10,076
OCCUPANCY: A-2
BUILDING PLANS FOR: NEW ☐ REMODEL EXISTING ☒ ADDITION ☐
CONSTRUCTION TYPE V 1HR SPRINKLED
FIRE FLOW REQUIRED / FIRE HYDRANTS REQUIRED / ATLAS PAGE # G-20

NAME (INSPECTOR)
PLANS DISAPPROVED DATE 8-11-99
PLANS APPROVED DATE 8-20-99

PLANS CORRECTIONS REQUIRED:
(INDICATE CONSTRUCTION ORDINANCE SECTION REFERENCE)

(1) SHOW EXIT AND EMERGENCY LIGHTING W/BATTERY BACK UP.

7. UNIFORM BUILDING CODE

(505) 924-3956

Notes:
1. Premises shall not be occupied until a Certificate of Occupancy has been issued, in accordance with Sec. 108, Albuquerque Uniform Administrative Code.
2. All windows and doors required to meet forced entry requirements shall bear identification indicating they conform to Ch. 41 of the New Mexico Uniform Building Code.

Description of Work Interior Remodel
Size of Bldg. (total) Sq. Ft. 10,076 ☒ Occupancy Group A-2.1
Type of Construction V 1hr Sprinkled Year of Applicable UBC 1994

NAME
PLANS DISAPPROVED DATE 8-10-99
PLANS APPROVED DATE 9-20-99

PLANS CORRECTIONS REQUIRED:
(INDICATE CONSTRUCTION ORDINANCE SECTION REFERENCE)

(1) UPDATE CODE TO Current Year 1997 UMBC 1997 NEC 1996 Elec. est.

8. UPC, UMC, NEC.

(505) 924-3957

Notes:
1. Every Furnace or water heater room shall have an opening or door and passageway thereto not less than 2 feet in width and large enough to permit removal of the largest furnace in such room. The furnace shall be installed so as to permit its removal without disturbing the piping or conduit and appurtenant valves or junction boxes.

NAME
PLANS DISAPPROVED DATE 8/18/99 & 9/21/99
PLANS APPROVED DATE 10/27/99

PLANS CORRECTIONS REQUIRED:
(INDICATE CONSTRUCTION ORDINANCE SECTION REFERENCE)

(1) Information on Plans and Specifications. Plans shall be drawn to scale upon substantial paper or cloth and shall be of sufficient clarity to indicate the nature and extent of the work proposed and show in detail that it will conform to the provisions of the technical codes and all relevant laws, ordinances, rules and regulations. Information on plans and specifications shall include but not be limited to the following:
TWO COMPLETE SETS OF ELECT., MECH, AND PLUMBING DRAWINGS.
(2) USE 1997-UBC, 1997UMC, & 1997 UPC.
(3) PROVIDE FAULT CURRENT INFO.
(4) PANEL SCHEDULES FOR PANELS "D" & "K"?
(5) MISSING INFO PANELS "LA" & "LB".
(6) [redacted] ELECT. LOAD CALCS.?
** REVISE DRAWING PER NOTES AND RESUBMIT NEW PLANS PRIOR TO APPROVAL.

CITY OF ALBUQUERQUE

RE DATE 7/2001 OF ESP

CITY OF ALBUQUERQUE

This microimage is certified as a true and accurate copy of the original as it appears in the files of the and was filmed in the regular course of business.

The photographic process used meets the Basic Microfilm Standards of the National Micrographics Association (NMA133-1977).

DIRECTOR

NOTARY PUBLIC

Commission expires: 10/22/2001

THIS MICROIMAGE IS THE BEST POSSIBLE REPRODUCTION DUE TO THE POOR QUALITY OF THE ORIGINAL DOCUMENT.

S. TOUB & ASSOCIATES, INC.
Consulting Engineer • Mechanical / Electrical

October 8, 1999

David Williams
Burson & Williams Architects, Inc.
3838 Oak Lawn Ave., Suite 1505
Dallas, TX 75219

RE: **CEC ALBUQUERQUE**
STA Project No. 3241

Dear ~~David,~~ Sirs ??

We have revised sheets E1, E2, and E3. The revision is marked as Delta 2 dated 10-07-99. The changes are as follows:

E1: Added a note to identify light fixture type "R".

E2: Added location of Main Panel "MP", revised location of the existing pad mounted transformer, added notes by symbol 1-2-and 3.

E3: Added panelboard schedules C and K, corrected panelboard schedules LA and LB, provided fault current circuit amps numbers on the Riser Diagram. Provided "Electrical load summary".

Please don't hesitate to call if we can answer any questions.

Sincerely,
S. TOUB & ASSOCIATES, INC.

George C. Hammons
Vice President

GCH:kad

13641 Omega Road
Dallas, Texas 75244
972/386-5828 Fax: 972/385-7274

CITY OF ALBUQUERQUE
THIS MICROIMAGE IS THE BEST POSSIBLE REPRODUCTION DUE TO THE POOR QUALITY OF THE ORIGINAL DOCUMENT.

R# 79 DATE 1-31-01 OP ESP

CITY OF ALBUQUERQUE

This microimage is certified to be a complete and accurate copy of the original as it appears in the files of the
Planning Department
and was created in the normal course of business.

The photographic process used meets the Basic Microfilm Standards of the National Micrographics Association (MS115-1977)

Richard Gutrich
DIRECTOR

NOTARY PUBLIC

Commission expires: 10/22/2001

D 24 C 20 B 16 A 12

CITY OF ALBUQUERQUE

CODE INFORMATION

ZONING	ALBUQUERQUE PLANNING DEPT.
PARKING REQUIRED:	EXISTING – NO CHANGE
PARKING PROVIDED:	EXISTING – NO CHANGE

BUILDING	1997 NEW MEXICO UNIFORM BUILDING CODE
OCCUPANCY CLASS:	A–2.1
CONSTRUCTION TYPE:	TYPE V, ONE–HOUR, SPRINKLERED
ALLOWABLE AREA:	10,500 S.F.
BUILDING AREA:	10.076 S.F.
TOTAL SEATING:	333 PERSONS
NEW OCCUPANT LOAD:	545 PERSONS
REQUIRED EXITS:	2 REQUIRED, 3 PROVIDED
MECHANICAL	1997 NEW MEXICO UNIFORM MECHANICAL CODE
ELECTRICAL	1999 NEW MEXICO ELECTRICAL CODE
HEALTH	CITY HEALTH CODE, ARTICLE 6
FIRE	1991 UNIFORM FIRE CODE
ACCESSABILITY	ADA
SIGNS	1991 UNIFORM SIGN CODE

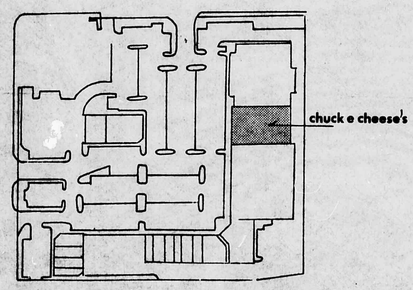

01 SITE PLAN (FOR REFERENCE ONLY)

CHUCK E CHEESE'S

ALBUQUERQUE, NEW MEXICO UNIT NO. 332

4418 WYOMING BLVD., N.E. - ALBUQUERQUE, NEW MEXICO - 87111

OWNER
C.E.C. ENTERTAINMENT, INC.
4441 WEST AIRPORT FREEWAY
P.O. BOX 152077
IRVING, TEXAS 75062
(972) 258–8507

ARCHITECT
C.T. CHANG AND ASSOC., INC.
1010 WEST EULESS BLVD., STE.110
EULESS, TEXAS 76040
(817) 354–6010

M.E.P. CONSULTANT
S. TOUB & ASSOCIATES
13641 OMEGA ROAD
DALLAS, TEXAS 75244
(972) 386–5629

PROJECT ADMINISTRATOR
BURSON & WILLIAMS
3838 OAKLAWN, STE.#1505
DALLAS, TEXAS 75219
(214) 520–2221

VICINITY MAP
NOT TO SCALE

TRUE NORTH

PROJECT LOCATION

THESE DOCUMENTS ARE THE SOLE PROFERTY OF C.E.C. ENTERTAINMENT, INC. ANY COPYING OR USE OF THESE DOCUMENTS FOR ANY PURPOSE OTHER THAN CONSTRUCTION OF THIS PROJECT WITHOUT THE EXPRESS WRITTEN PERMISSION OF THE ARCHITECT AND CEC ENTERTAINMENT, INC. IS PROHIBITED.

STATE OF NEW MEXICO
C.T. CHANG
No. 7358
REGISTERED ARCHITECT

INDEX OF DRAWINGS

		DATE
	COVER SHEET INFORMATION	07/28/99
A1	FLOOR PLAN	1 09/09/99
A2	ENLARGED KITCHEN PLAN	
A3	REFLECTED CEILING PLAN	
A4	EXTERIOR ELEVATIONS	
A5	INTERIOR ELEVATIONS	
E1	FLOOR PLAN– LIGHTING	1
E2	FLOOR PLAN–POWER	
E3	SCHEDULES & RISERS	

ALBUQUERQUE BUILDING & SAFETY
SEP 2 0 1999
U.B.C. PLAN CHECK SECTION

3241

NO SUBSTITUTION OF PRODUCTS, MATERIALS OR EQUIPMENT SPECIFIED HEREIN WILL BE ALLOWED UNLESS SUBMITTED WITH SUBSTANTIATING DATA PRIOR TO INSTALLATION, AND APPROVED IN WRITING BY CEC ENTERTAINMENT, INC.

ALBUQUERQUE, NEW MEXICO #332 98–180

PLAN SHOT TWICE
ONCE ON LIGHT
ONCE ON DARK

CITY OF ALBUQUERQUE
THIS MICROIMAGE IS THE BEST POSSIBLE REPRODUCTION DUE TO THE POOR QUALITY OF THE ORIGINAL DOCUMENT.

R# 79 DATE 1-31-01 OP EXP

CITY OF ALBUQUERQUE
This microimage is certified to be a complete and accurate copy of the original as it appears in the files of the Planning Department and was created in the normal course of business.
The photographic process used meets the Basic Microfilm Standards of the National Micrographics Association (MS115-1977)
Richard Dutch
DIRECTOR
Margaret D. Garcia
NOTARY PUBLIC
Commission expires: 10/22/2001

D 2 C 20 b 10 12

CITY OF ALBUQUERQUE

CODE INFORMATION

ZONING	ALBUQUERQUE PLANNING DEPT.
PARKING REQUIRED:	EXISTING – NO CHANGE
PARKING PROVIDED:	EXISTING – NO CHANGE
BUILDING	1997 NEW MEXICO UNIFORM BUILDING CODE
OCCUPANCY CLASS:	A-2.1
CONSTRUCTION TYPE:	TYPE V, ONE-HOUR, SPRINKLERED
ALLOWABLE AREA:	10,500 S.F.
BUILDING AREA:	10,076 S.F.
TOTAL SEATING:	333 PERSONS
NEW OCCUPANT LOAD:	545 PERSONS
REQUIRED EXITS:	2 REQUIRED, 3 PROVIDED
MECHANICAL	1997 NEW MEXICO UNIFORM MECHANICAL CODE
ELECTRICAL	1999 NEW MEXICO ELECTRICAL CODE
HEALTH	CITY HEALTH CODE, ARTICLE 6
FIRE	1991 UNIFORM FIRE CODE
ACCESSABILITY	ADA
SIGNS	1991 UNIFORM SIGN CODE

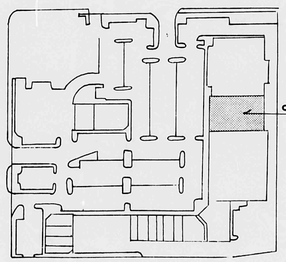

01 SITE PLAN (FOR REFERENCE ONLY)

CHUCK E CHEESE'S

ALBUQUERQUE, NEW MEXICO UNIT NO. 332

4418 WYOMING BLVD., N.E. - ALBUQUERQUE, NEW MEXICO - 87111

OWNER
C.E.C. ENTERTAINMENT, INC.
4441 WEST AIRPORT FREEWAY
P.O. BOX 152077
IRVING, TEXAS 75062
(972) 258-8507

ARCHITECT
C.T. CHANG AND ASSOC., INC.
1010 WEST EULESS BLVD., STE.110
EULESS, TEXAS 76040
(817) 354-6010

M.E.P. CONSULTANT
S. TOUB & ASSOCIATES
13641 OMEGA ROAD
DALLAS, TEXAS 75244
(972) 386-5629

PROJECT ADMINISTRATOR
BURSON & WILLIAMS
3838 OAKLAWN, STE.#1505
DALLAS, TEXAS 75219
(214) 520-2221

VICINITY MAP

NOT TO SCALE

PROJECT LOCATION

TRUE NORTH

THESE DOCUMENTS ARE THE SOLE PROPERTY OF C.E.C. ENTERTAINMENT, INC. ANY COPYING OR USE OF THESE DOCUMENTS FOR ANY PURPOSE OTHER THAN CONSTRUCTION OF THIS PROJECT WITHOUT THE EXPRESS WRITTEN PERMISSION OF THE ARCHITECT AND CEC ENTERTAINMENT, INC. IS PROHIBITED.

STATE OF NEW MEXICO
C.T. CHANG
No. 2558
REGISTERED ARCHITECT

INDEX OF DRAWINGS

		DATE
	COVER SHEET INFORMATION	07/28/99
A1	FLOOR PLAN	⚠ 09/09/99
A2	ENLARGED KITCHEN PLAN	
A3	REFLECTED CEILING PLAN	
A4	EXTERIOR ELEVATIONS	
A5	INTERIOR ELEVATIONS	
E1	FLOOR PLAN- LIGHTING	
E2	FLOOR PLAN-POWER	
E3	SCHEDULES & RISERS	

NO SUBSTITUTION OF PRODUCTS, MATERIALS OR EQUIPMENT SPECIFIED HEREIN WILL BE ALLOWED UNLESS SUBMITTED WITH SUBSTANTIATING DATA PRIOR TO INSTALLATION, AND APPROVED IN WRITING BY CEC ENTERTAINMENT, INC.

ALBUQUERQUE, NEW MEXICO #332 98-180

PLAN SHOT TWICE
ONCE ON LIGHT
ONCE ON DARK

CITY OF ALBUQUERQUE
THIS MICROIMAGE IS THE BEST POSSIBLE REPRODUCTION DUE TO THE POOR QUALITY OF THE ORIGINAL DOCUMENT.

R# 74 DATE 1-31-01 OF 27

CITY OF ALBUQUERQUE

This microimage is certified to be a complete and accurate copy of the original as it appears in the files of the Planning Department and was created in the normal course of business.

The photographic process used meets the Basic Microfilm Standards of the National Micrographics Association (MS115-1977)

Richard Mortich
DIRECTOR

Margaret D. Garcia
NOTARY PUBLIC
Commission expires: 10/22/2001

D C b 12

D 2 20 10

CITY OF ALBUQUERQUE

CODE ADMINISTRATION PLANS

ADD: 4418 WYOMING BLVD. N.E.

DES: REMODEL

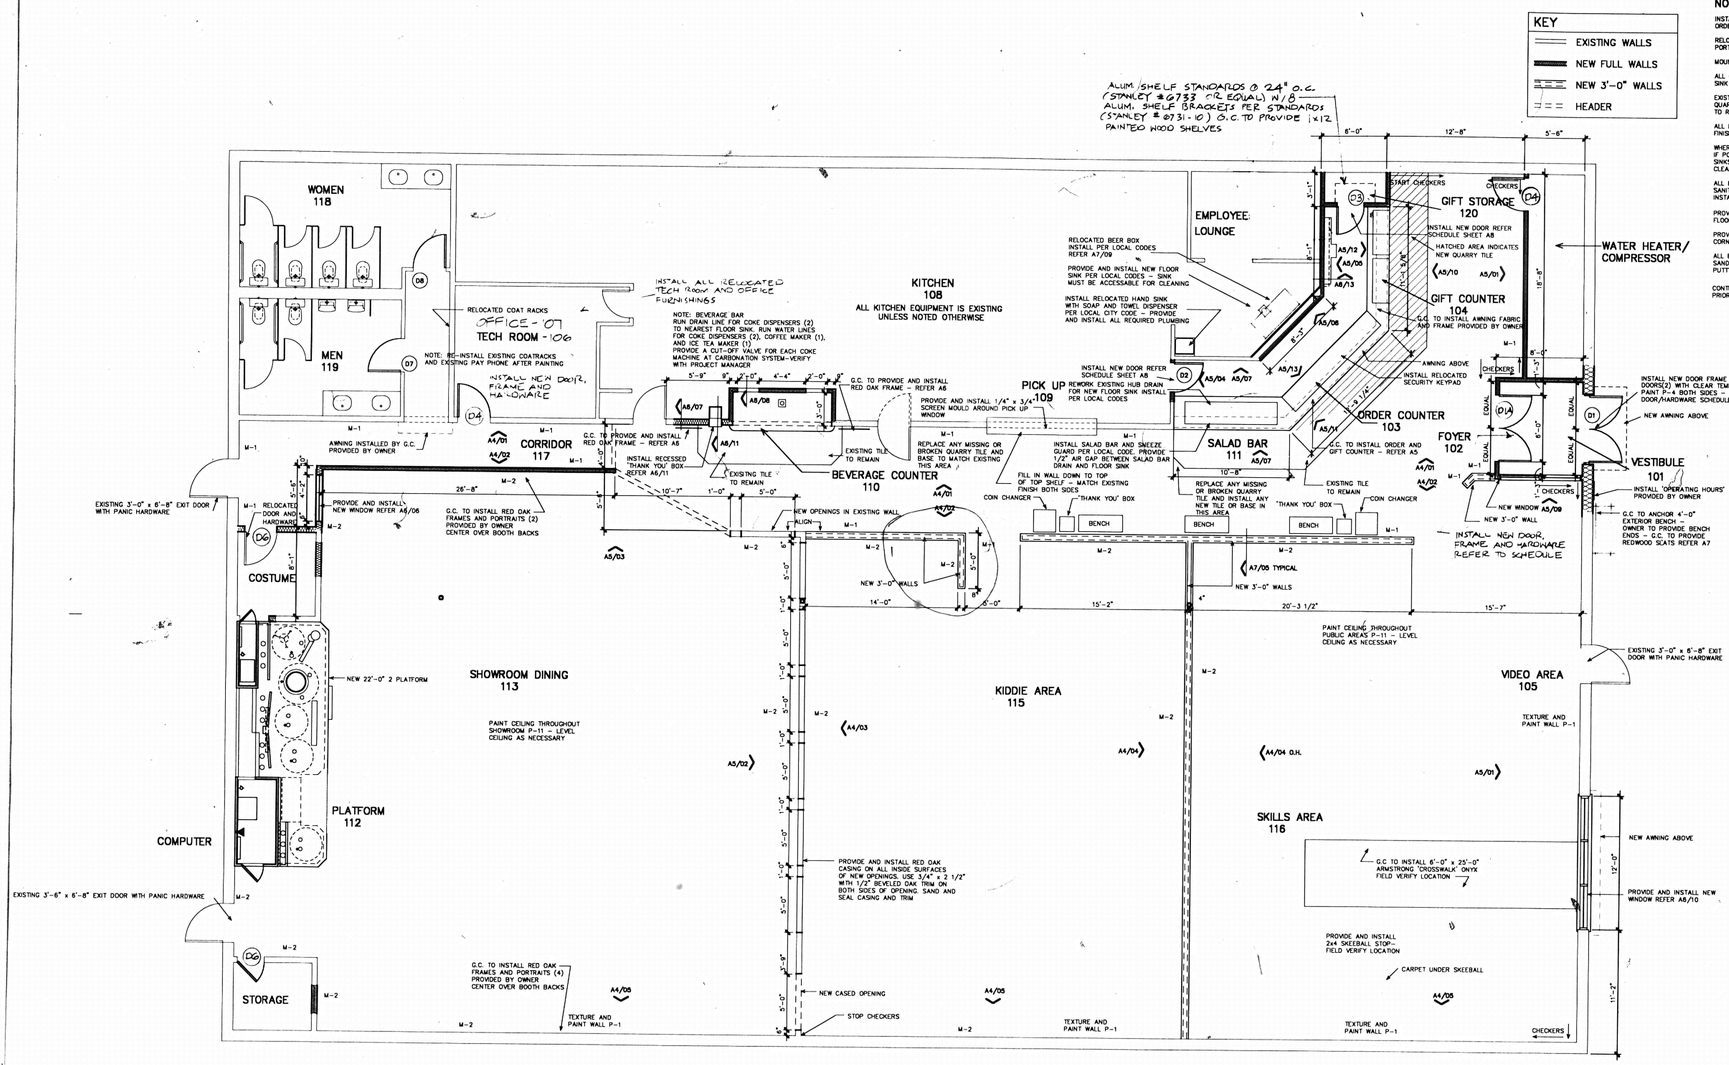

NOTES:

INSTALL BEVERAGE AND ORDER DROP BOXES IN NEW ORDER COUNTER.

RELOCATE GUEST CHECK HOLDER TO BOTTOM OF PORTION CHART.

MOUNT PORTION CHART 1'-0" ABOVE MAKE TABLE.

ALL CONDENSATE TO DISCHARGE INTO A FLOOR SINK (VIA A 1" AIR GAP).

EXISTING QUARRY TILE AND 6" SANITARY COVE QUARRY BASE IN KITCHEN AND PREP AREA TO REMAIN.

ALL FLOOR SINKS TO BE INSTALLED FLUSH WITH FINISH FLOOR.

WHERE FLOOR SINKS ARE REQUIRED USE EXISTING IF POSSIBLE INSTALL NEW OTHERWISE. FLOOR SINKS SHOULD BE 1/2 EXPOSED FOR ACCESSIBLE CLEANING.

ALL EQUIPTMENT SHALL MEET APPLICABLE NATIONAL SANITATION FOUNDATION (NSF) DESIGN AND INSTALLATION REQUIREMENTS OR ITS EQUIVALENT.

PROVIDE TRANSITION STRIPS AT ALL CHANGES IN FLOORING MATERIAL

PROVIDE AND INSTALL AT ALL WALL CORNERS CLEAR CORNER GUARDS APPLIED WITH CLEAR SILICONE

ALL EXISTING DOORS TO BE PAINTED REQUIRE SANDING AND FIELD REPAIR OF DAMAGE WITH WOOD PUTTY BEFORE PAINTING

CONTRACTOR TO VERIFY CONDITIONS & DIMENSIONS PRIOR TO CONSTRUCTION

NOTE:
M-2 = MARLITE 5407 "BUFF"
M-1 = MARLITE 328-BG2 "NATURAL OAK"

01 FLOOR PLAN
SCALE: 3/16" = 1'-0"

C. C. KOEHLER, CONSULTING ARCHITECT, A.I.A.

B&W BURSON AND WILLIAMS ARCHITECTS INC.
8333 Gaston Avenue • Dallas, Texas 75214 • 214/373-4711

STATE OF NEW MEXICO — ELEMENTS OF ARCHITECTURE — C. C. KOEHLER — 433 — REGISTERED ARCHITECT

CHUCK E. CHEESE'S

THESE DOCUMENTS ARE THE SOLE PROPERTY OF SHOWBIZ PIZZA TIME, INC. ANY COPYING OR USE OF THESE DOCUMENTS FOR ANY PURPOSE OTHER THAN CONSTRUCTION OF THIS PROJECT WITHOUT THE EXPRESS WRITTEN PERMISSION OF THE ARCHITECT AND SHOWBIZ PIZZA IS PROHIBITED.

CHUCK E. CHEESE'S PIZZA #3161 – ALBUQUERQUE
4418 WYOMING NE – ALBUQUERQUE, NEW MEXICO – 87111
SPRING VALLEY AMUSEMENT, INC.
5776 ARROWHEAD DRIVE • SUITE 108
VIRGINIA BEACH, VIRGINIA 23462

FLOOR PLAN

Date
04 AUGUST 1992

Revisions

Project Number
92-090

Sheet Number
A3
of 8

REV 340 DATE 6/4/93 OP EDP

CITY OF ALBUQUERQUE

This microimage is certified to be a complete and accurate copy of the original as it appears in the files of the CODE ADMINISTRATION DIVISION and was filmed in the normal course of business.
The photographic processes used meet the Basic Microfilm Standards of the National Micrographics Association (NS115-1977).

Karen Aiken
CITY CLERK RECORDER

OFFICIAL SEAL
NORBERTA SANCHEZ
NOTARY PUBLIC
STATE OF NEW MEXICO
My Commission Expires MAY 5, 1995
Norberta Sanchez

D 24 C 20 B 16 A 12

CITY OF ALBUQUERQUE

C D

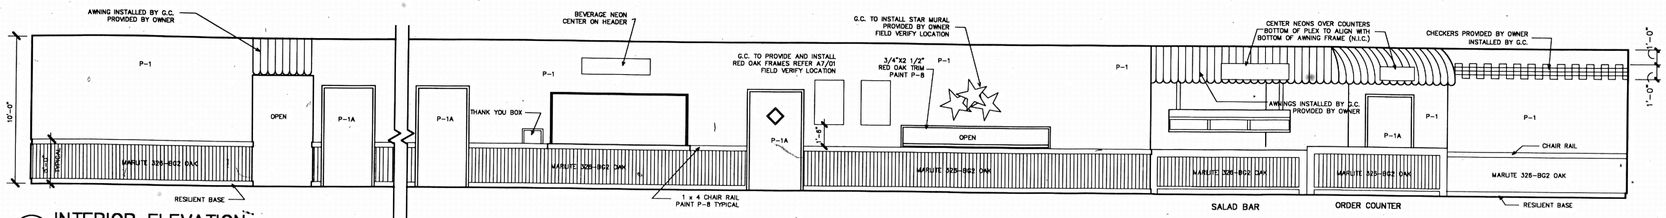

01 INTERIOR ELEVATION

SCALE: 1/4" = 1'-0"

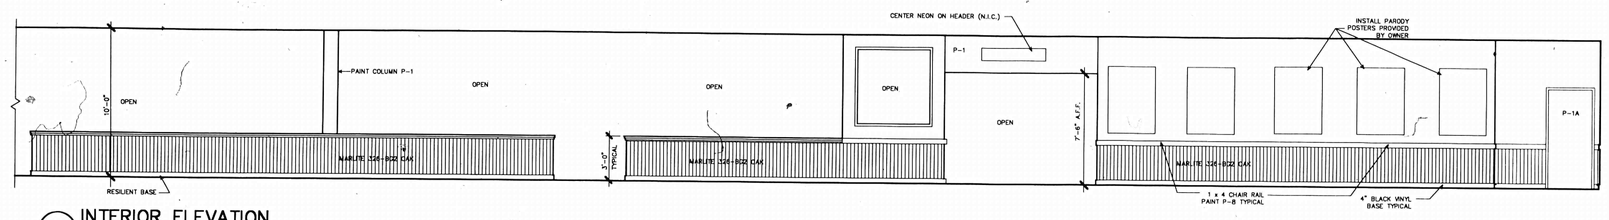

02 INTERIOR ELEVATION

SCALE: 1/4" = 1'-0"

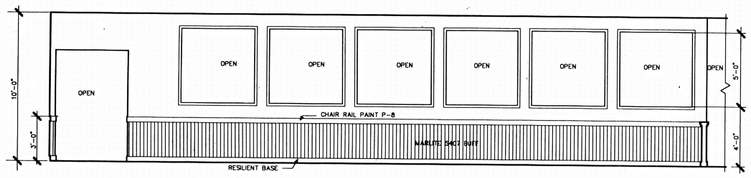

03 INTERIOR ELEVATION

SCALE: 1/4" = 1'-0"

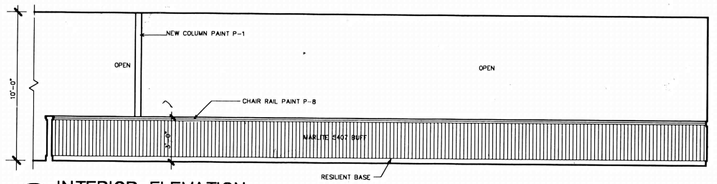

04 INTERIOR ELEVATION

SCALE: 1/4" = 1'-0"

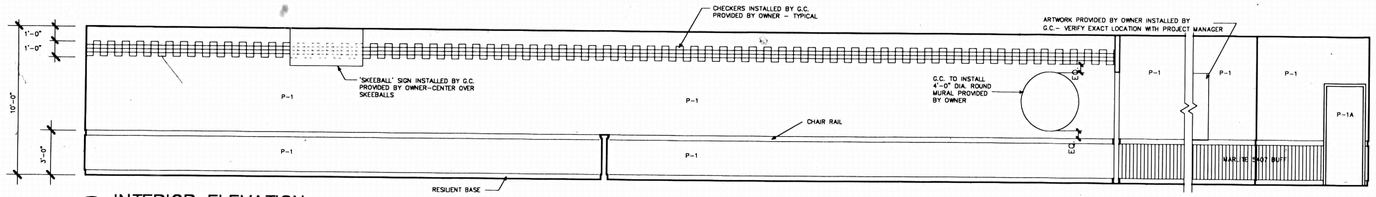

05 INTERIOR ELEVATION

SCALE: 1/4" = 1'-0"

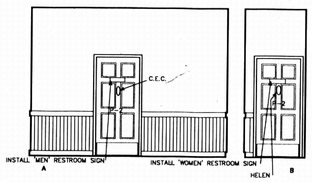

07 INTERIOR ELEVATION

SCALE: 1/4" = 1'-0"

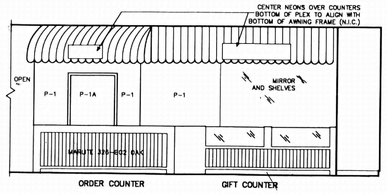

06 INTERIOR ELEVATION

SCALE: 1/4" = 1'-0"

C. C. WHEELER, CONSULTING ARCHITECT, A.I.A.

BURSON WILLIAMS ARCHITECTS INC.
3003 Main Street • Dallas, Texas 75226 • 214/741-0774

REGISTERED ARCHITECT — STATE OF NEW MEXICO — JAMES C. BURSON — 5043 — TEXAS

CHUCK E. CHEESE

THESE DOCUMENTS ARE THE SOLE PROPERTY OF SHOWBIZ PIZZA TIME, INC. ANY COPYING OR USE OF THESE DOCUMENTS FOR ANY PURPOSE OTHER THAN CONSTRUCTION OF THIS PROJECT WITHOUT THE EXPRESS WRITTEN PERMISSION OF THE ARCHITECT AND SHOWBIZ PIZZA IS PROHIBITED.

CHUCK E. CHEESE'S PIZZA #3161 – ALBUQUERQUE
4418 WYOMING NE – ALBUQUERQUE, NEW MEXICO – 87111

SPRING VALLEY AMUSEMENT, INC
5770 ARROWHEAD DRIVE, SUITE 108
VIRGINIA BEACH, VIRGINIA 23462

INTERIOR ELEVATIONS

Date
04 august 1992

Revisions

Project Number
92-090

Sheet Number
A4
of 8

REV 540 DATE 6/4/92 OP EJP
CITY OF ALBUQUERQUE
This microimage is certified to be a complete and accurate copy of the original as it appears in the files of the CODE ADMINISTRATION DIVISION and was filmed in the normal course of business. The photographic processes used meet the Basic Microfilm Standards of the National Micrographics Association (NS115-1977).
Karen Aermer
CITY CLERK RECORDER
OFFICIAL SEAL NORBERTA SANCHEZ NOTARY PUBLIC STATE OF NEW MEXICO
My Commission Expires MAY 6, 1995
Norberta Sanchez

D 24 C 20 B 16 A 12

CITY OF ALBUQUERQUE

C D

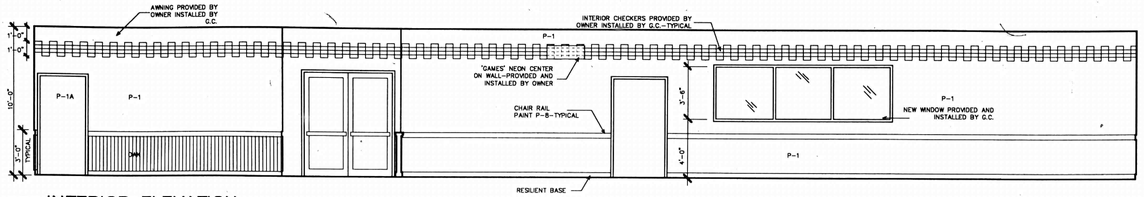

01 INTERIOR ELEVATION

SCALE: 1/4" = 1'-0"

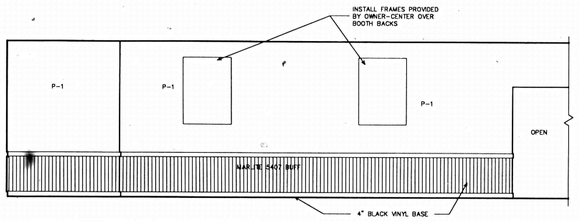

02 INTERIOR ELEVATION

SCALE: 1/4" = 1'-0"

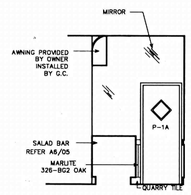

04 INTERIOR ELEVATION

SCALE: 1/4" = 1'-0"

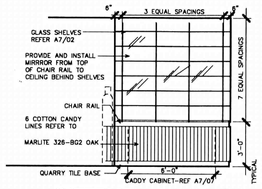

05 INTERIOR ELEVATION

SCALE: 1/4" = 1'-0"

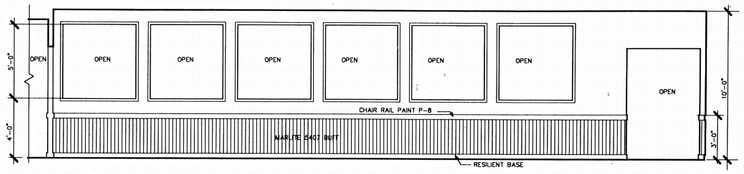

03 INTERIOR ELEVATION

SCALE: 1/4" = 1'-0"

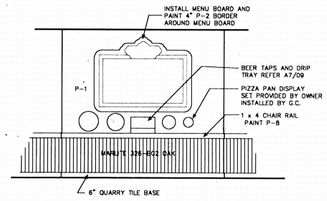

06 INTERIOR ELEVATION

SCALE: 1/4" = 1'-0"

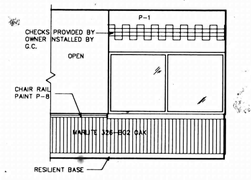

08 INTERIOR ELEVATION

SCALE: 1/4" = 1'-0"

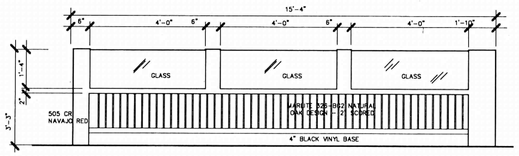

10 GIFT COUNTER-FRONT

SCALE: 1/2" = 1'-0"

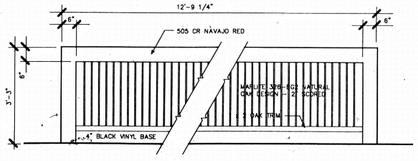

11 ORDER COUNTER-FRONT

SCALE: 1/2" = 1'-0"

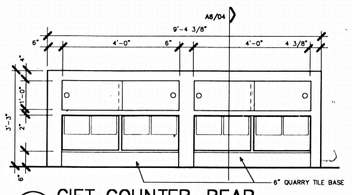

12 GIFT COUNTER-REAR

SCALE: 1/2" = 1'-0"

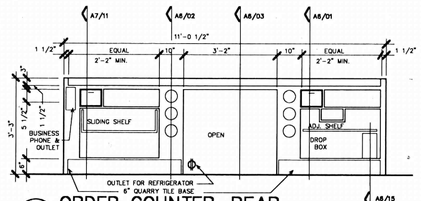

13 ORDER COUNTER-REAR

SCALE: 1/2" = 1'-0"

C. C. KOCHER, CONSULTING ARCHITECT, A.I.A.

B&W BURSON & WILLIAMS ARCHITECTS INC.

8500 Menaul Blvd. N.E. • Suite B-450 • Albuquerque, New Mexico 87112 • (505) 237-3111

STATE OF NEW MEXICO — CLEMENTS C. KOCHER — 7721 — REGISTERED ARCHITECT

CHUCK E. CHEESE'S

THESE DOCUMENTS ARE THE SOLE PROPERTY OF SHOWBIZ PIZZA TIME, INC. ANY COPYING OR USE OF THESE DOCUMENTS FOR ANY PURPOSE OTHER THAN CONSTRUCTION OF THIS PROJECT WITHOUT THE EXPRESS WRITTEN PERMISSION OF THE ARCHITECT AND SHOWBIZ PIZZA IS PROHIBITED.

CHUCK E. CHEESE'S PIZZA #3161 – ALBUQUERQUE
4418 WYOMING NE – ALBUQUERQUE, NEW MEXICO – 87111

SPRING VALLEY AMUSEMENT, INC.
5776 ARROWHEAD DRIVE • SUITE 108
VIRGINIA BEACH, VIRGINIA 23462

INTERIOR ELEVATIONS

Date
04 AUGUST 1992

Revisions

Project Number
92-090

Sheet Number
A5
of 8

CITY OF ALBUQUERQUE

This microimage is certified to be a complete and accurate copy of the original as it appears in the files of the CODE ADMINISTRATION DIVISION and was filmed in the normal course of business. The photographic processes used meet the Basic Microfilm Standards of the National Micrographics Association (NS115-1977).

CITY CLERK RECORDER

OFFICIAL SEAL NORBERTA SANCHEZ NOTARY PUBLIC STATE OF NEW MEXICO My Commission Expires MAY 6, 1995

D 24 C 20 B 16 A 12 C D

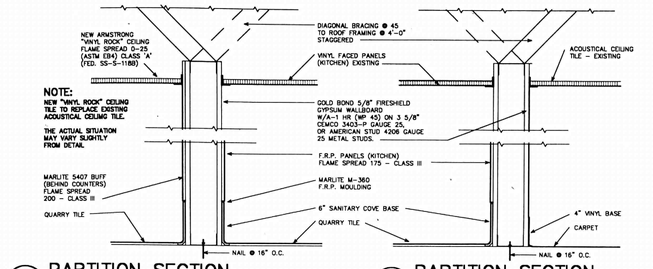

13 PARTITION SECTION

SCALE: 1 1/2" = 1'-0"

14 PARTITION SECTION

SCALE: 1 1/2" = 1'-0"

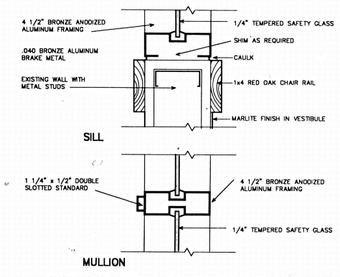

10 DETAIL FOR VESTIBULE WINDOW

SCALE: 3" = 1'-0"

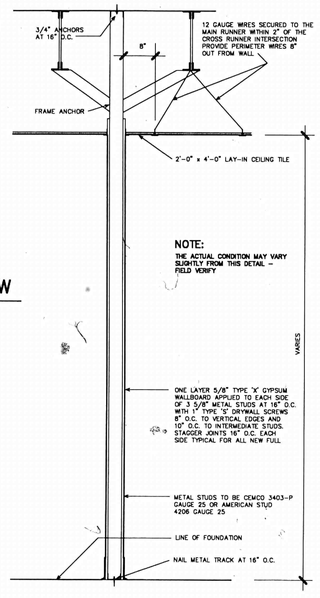

07 NEW INTERIOR PARTITION

SCALE: 3/4" = 1'-0" TYPICAL SECTION

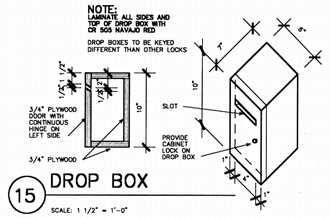

15 DROP BOX

SCALE: 1 1/2" = 1'-0"

CEILING BRACING NOTES

1. Four No. 12 gauge wires must be secured to the main runner within 2 inches of the cross runner intersection and splayed 90 degrees from each other at an angle not exceeding 45 degrees from the plane of the ceiling. A strut fastened to the main runner shall be extended to and fastened to the structural members supporting the roof or floor above. The strut shall be adequate to resist the vertical component induced by the bracing wires. These horizontal restraint points shall be placed 12 feet on center in both directions with the first point within 6 feet from each wall. Attachment of the restraint wires to the structure above shall be adequate for the load imposed.
2. Lateral force bracing members shall be spaced a minimum of 6 inches from all horizontal piping or duct work that is not provided with bracing restraints for horizontal forces. Bracing wires shall be attached to the grid and to the structure in such a manner that they can support a design load of not less than 200 pounds or the actual load, whichever is greater, with a safety factor of 2.

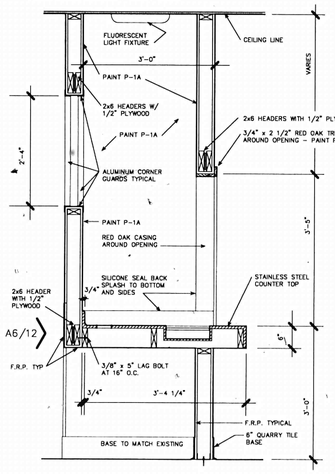

08 BEVERAGE BAR SECTION

SCALE: 3/4" = 1'-0"

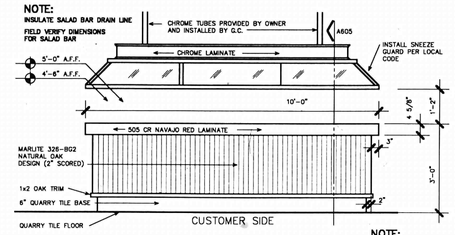

16 SALAD BAR ELEVATION

SCALE: 1/2" = 1'-0"

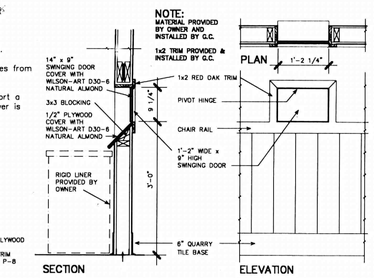

11 RECESSED THANK YOU DOOR

SCALE: 3/4" = 1'-0"

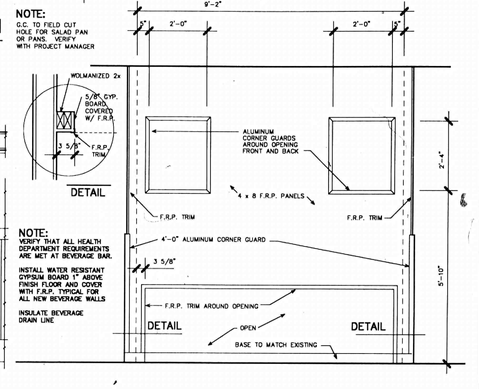

12 BEVERAGE BAR BACK ELEVATION

SCALE: 1/2" = 1'-0"

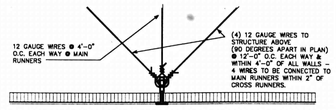

17 SUSPENDED CEILING LATERAL TIE

SCALE: 3" = 1'-0"

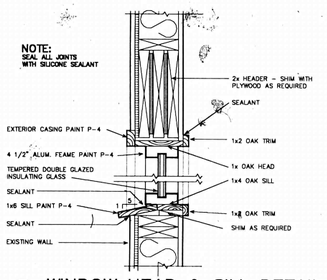

06 WINDOW HEAD & SILL DETAIL

SCALE: 1 1/2" = 1'-0" JAMB SIMILAR

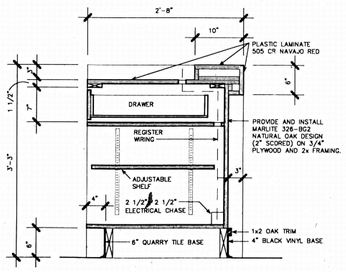

01 SECTION @ ORDER COUNTER

SCALE: 1" = 1'-0"

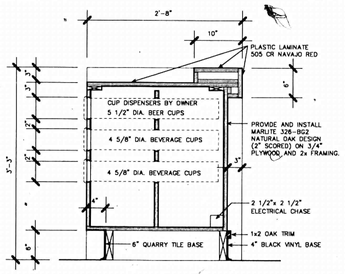

02 SECTION @ ORDER COUNTER

SCALE: 1" = 1'-0"

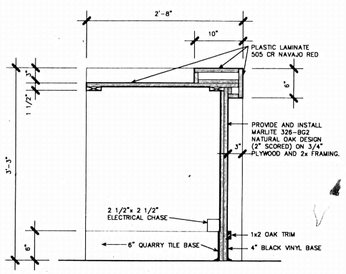

03 SECTION @ ORDER COUNTER

SCALE: 1" = 1'-0"

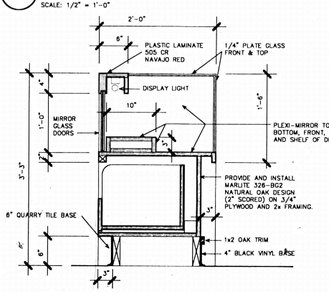

04 SECTION @ GIFT COUNTER

SCALE: 1" = 1'-0"

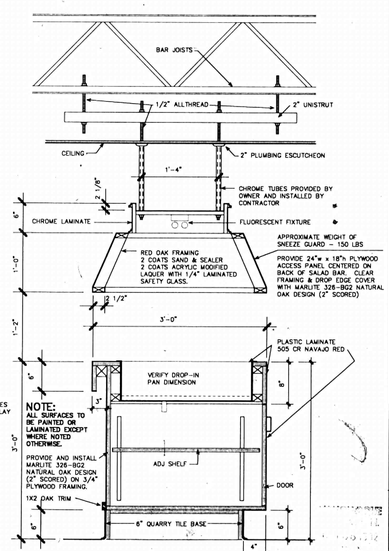

05 SECTION @ SALAD BAR

SCALE: 1" = 1'-0"

C. C. MOEHLER, CONSULTING ARCHITECT, A.I.A.

BURSON AND WILLIAMS ARCHITECTS INC.
3613 Wisla Street • Dallas, Texas 75244 • 214/661-9776

STATE OF NEW MEXICO — CHARLES C. MOEHLER — 1975 — REGISTERED ARCHITECT

CHUCK E. CHEESE'S PIZZA #3161 - ALBUQUERQUE
4418 WYOMING NE - ALBUQUERQUE, NEW MEXICO - 87111
SPRING VALLEY AMUSEMENTS, INC.
4294 VIRGINIA BEACH BLVD. SUITE 108
VIRGINIA BEACH, VIRGINIA 23462

COUNTERS AND DETAILS

THESE DOCUMENTS ARE THE SOLE PROPERTY OF SHOWBIZ PIZZA TIME, INC. ANY COPYING OR USE OF THESE DOCUMENTS FOR ANY PURPOSE OTHER THAN CONSTRUCTION OF THIS PROJECT WITHOUT THE EXPRESS WRITTEN PERMISSION OF THE ARCHITECT AND SHOWBIZ PIZZA IS PROHIBITED.

Date
04 AUGUST 1992

Revisions

Project Number
92-090

Sheet Number
A6
of 8

Ref 440 DATE 6/4/93 OP EP
CITY OF ALBUQUERQUE
This microimage is certified to be a complete and accurate copy of the original as it appears in the files of the CODE ADMINISTRATION DIVISION and was filmed in the normal course of business.
The photographic processes used meet the Basic Microfilm Standards of the National Micrographics Association (NS115-1977).
Karen Aimes
CITY CLERK RECORDER
OFFICIAL SEAL NORBERTA SANCHEZ NOTARY PUBLIC STATE OF NEW MEXICO
My Commission Expires MAY 8, 1995
Norberta Sanchez

D 24 C 20 B 16 A 12

CITY OF ALBUQUERQUE

C D

ADD: 4418 WYOMING BLVD. N.E.

DES: REMODEL

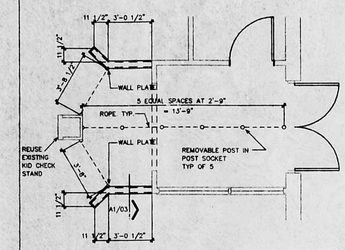

G.C. TO PROVIDE HARDWARE, STATION AND ROPE FOR KID CHECK AREA AS SHOWN

CORE DRILL 2 1/4" DIAMETER HOLES 4 1/4" DEEP FOR POST SOCKETS

ALL ITEMS HAVE BRASS FINISH UNLESS NOTED OTHERWISE

REGAL REMOVABLE POST (BLACK IRON NATURAL FINISH) (INCLUDES CROWN AND BASE)	5	BR-7
ROPE 3'-9" W/ SWAY-RED	2	BR-8
ROPE 2'-9" W/ SWAY RED	5	BR-8
WALL PLATE	2	BR-8

G.C. IS RESPONSIBLE FOR VERIFYING ALL ROPES, SIZES AND DIMENSIONS BEFORE ORDERING OR DRILLING

02 ENLARGED ENTRY

SCALE : 1/4" = 1'-0"

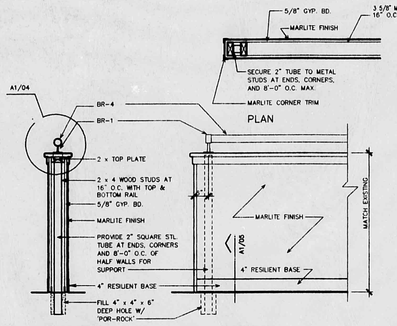

03 TYPICAL HALF WALL

SCALE: 3/4" = 1'-0"

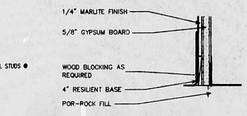

05 BASE DETAIL

SCALE : 3" = 1'-0"

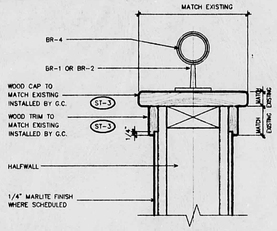

04 OAK CAP AT HALF WALL

SCALE: 3"=1'-0"

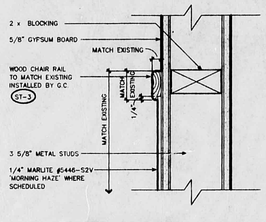

06 CHAIR RAIL

SCALE: 3" = 1'-0"

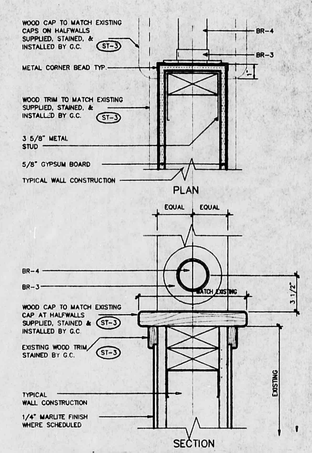

07 WALL OPENING DETAIL

SCALE: 3"=1'-0"

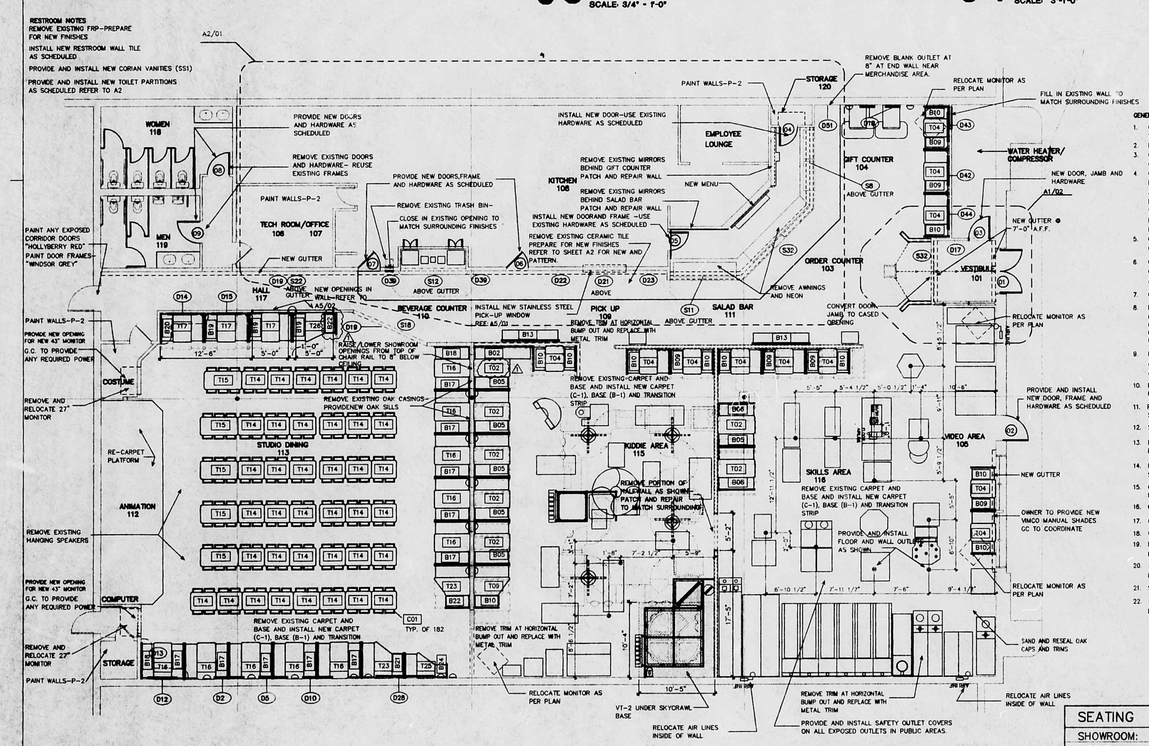

01 FLOOR PLAN

SCALE : 1/8" = 1'-0"

GENERAL NOTES

1. GENERAL CONTRACTOR RESPONSIBLE FOR RECEIVING, UNLOADING, AND INSPECTION AT TIME OF DELIVERY. REPORT ANY DAMAGE TO OWNER, AT TIME OF DELIVERY.
2. NOT USED.
3. GENERAL CONTRACTOR RESPONSIBLE FOR COORDINATION OF SECURITY SYSTEM. CONTACT OWNER FOR NAME OF SECURITY REPRESENTATIVE.
4. GENERAL CONTRACTOR SHALL PROVIDE AND INSTALL CURB AS REQUIRED FOR ROOF MOUNTED CONDENSER UNIT. GENERAL CONTRACTOR SHALL PROVIDE AND INSTALL ALL NECESSARY ELECTRICAL SERVICE TO WALK-IN COOLER, AND RELATED REFRIGERATION EQUIPMENT. COORDINATE ANY ROOF ALTERATIONS WITH APPROVED ROOFING CONTRACTOR.
   REFRIGERATION SERVICE CO. IS RESPONSIBLE FOR ALL PRE-CHARGED LINE WORK, AND EQUIPMENT START-UP ON WALK-IN COOLER AND ICE MACHINE.
5. GENERAL CONTRACTOR TO COORDINATE WITH OWNER'S TECHNICAL ADVISER ON COMPRESSED AIR REQUIREMENTS AND LOCATIONS.
6. G.C. WILL INSTALL WIRE ABOVE CEILING @ IN WALL FOR SOUND SYSTEM. OWNER WILL PROVIDE ALL SPEAKER WIRE. OWNER WILL FURNISH AND INSTALL ALL SPEAKERS, & MAKE FINAL CONNECTIONS AT SPEAKERS.
7. G.C. TO INSTALL WATER FILTER SYSTEM AS SHOWN ON PLANS.
8. PRIZE SHELVING PACKAGE TO INCLUDE.
   (4) EA. 5'-0" x 10" RED SHELVES W/ (3) BRACKETS EACH SHELF
   (4) EA. 4'-0" x 10" GREEN SHELVES W/ (2) BRACKETS EACH SHELF
   (6) EA. 3'-0" x 10" BLUE SHELVES W/ (2) BRACKETS EACH SHELF
   (6) EA. 2'-0" x 10" YELLOW SHELVES W/ (2) BRACKETS EACH SHELF
9. MOUNT S.S. COFFEE SHELF AT 32" A.F.F.; PROVIDE OUTLET AT 36" A.F.F.; DRAIN TO FLOOR SINK BELOW (FOR COFFEE AND BEER PAN)
10. REMOVE ALL EXISTING HORIZONTAL AND VERTICAL OAK TRIM. INSTALL METAL CORNER TRIM. PATCH AND REPAIR TO MATCH SURROUNDING FINISHES.
11. REMOVE EXISTING PIZZA CIRCLES. PATCH AND REPAIR WALLS TO MATCH SURROUNDING FINISHES.
12. SAND AND RESEAL ALL EXISTING OAK CAPS AND TRIMS.
13. PRIME AND PAINT ALL EXISTING OAK AND BUFF MARLITE P-5. REFER TO SHEET A2.
14. REMOVE EXISTING VINYL CHECKS. PATCH AND REPAIR WALL TO MATCH SURROUNDING FINISHES.
15. G.C. TO INSTALL WIRING FOR NEW OWNER SUPPLIED SOUND SYSTEM THROUGHOUT. NEW BOSE SYSTEM IN THE SHOWROOM.
16. G.C. TO INSTALL NON MOTORIZED "VMCO" SHADES ON ALL EXTERIOR WINDOWS.
17. G.C. TO VERIFY THAT ALL EXISTING DETEX HARDWARE ARE IN WORKING ORDER.
18. OWNER TO DRY CLEAN EXISTING STAGE CURTAINS.
19. INSTALL BLACK IRON RAILS WITH BRASS FITTINGS ON ALL HALF-WALLS. REFER TO A1/03
20. MAINTENCE IS TO VERIFY THE CONDITION OF ALL A/C MECHANICAL UNITS, ICE MACHINES, MAKE TABLES AND SALAD BAR REFRIGERATOR
21. SECURE ALL THERMOSTATS TO WALL OR REPLACE AS NECESSARY.
22. PROVIDE AND INSTALL (3) NEW RECESSED FIRE EXTINGUISHER CABINETS- LOCATE AS PER FIRE MARSHAL.

M - MILLWORK
K - KITCHEN
V - VENDOR
O - OWNER
G - GENERAL CONTRACTOR
S - SUPPLIER
N/A - NOT APPLICABLE

SEATING		AREA	
SHOWROOM:	250	SHOWROOM:	2,467
KIDDIE:	37	KIDDIE:	1,556
SKILLS:	28	SKILLS:	1,938
OTHER:	18	OTHER:	4,105
TOTAL:	333	TOTAL:	10,076 SQ.FT

ADDITIONAL EQUIPMENT & MILLWORK

MARK	DESCRIPTION	QTY	MANUFACTURER/MODEL NUMBER	REMARKS	FURNISHED	INSTALLED	HOOK-UP	START-UP
K02	SODA AND ICE DISPENSER	2	COKE VENDOR		V	V	V	V
K03								
K05	TEA DISPENSER	1	COKE VENDOR		V	V/S	V	V
K07	EXHAUST HOOD SYSTEM	1	CAPTIVAIRE MODEL #9030R	BLACK BOX FILTERS TO REMOVE OVER CARBONATES WITH WIND-UP AIR AND FIRE INCLUDES CURB	S	G	G	G
K20	SANDWICH TABLE	1	DELFIELD #6048-S	REFRIGERATED WORK TABLE	S	G	G	N/A
K21	ICE ACCESS DOORS	2	CUSTOM FABRICATED		G	G	N/A	N/A
M01								
M02	CUP CADDY	1	CUSTOM		O/M	G	N/A	N/A
M03	PRIZE CADDY	1	CUSTOM		O/M	G	N/A	N/A
M04	PRIZE CADDY SHELVING	1 SET	CUSTOM	REFER TO NOTE 8	O/M	G	N/A	N/A
M05	"THANK YOU" BOXES	3	CUSTOM		O/M	G	N/A	N/A
M06	DECOR SHELF	2	CUSTOM		O/M	G	N/A	N/A
M07	CONDIMENT STAND	2	CUSTOM		O/M	G	N/A	N/A

CHAIRS

MARK	DESCRIPTION	QTY	MANUFACTURER/MODEL NUMBER	REMARKS	FURNISHED	INSTALLED	HOOK-UP	START-UP
C1	CHAIRS	182	MTS		O/S	G	N/A	N/A
C2								
C3								
C4	EMPLOYEE STOOLS	0	MODERN LEATHERETTE MOLP		O/S	G	N/A	N/A

BOOTHS

B01								
B02	96" SINGLE SKILLS/KIDDIE BOOTH	1	CUSTOM		O/S	G	N/A	N/A
B03	84" SINGLE SKILLS/KIDDIE BOOTH	0	CUSTOM		O/S	G	N/A	N/A
B04	72" SINGLE SKILLS/KIDDIE BOOTH	0	CUSTOM		O/S	G	N/A	N/A
B05	60" DOUBLE SKILLS/KIDDIE BOOTH	6	CUSTOM		O/S	G	N/A	N/A
B06	60" SINGLE SKILLS/KIDDIE BOOTH	2	CUSTOM		O/S	G	N/A	N/A
B07	48" DOUBLE SKILLS/KIDDIE BOOTH	0	CUSTOM		O/S	G	N/A	N/A
B08	48" SINGLE SKILLS/KIDDIE BOOTH	0	CUSTOM		O/S	G	N/A	N/A
B09	42" DOUBLE SKILLS/KIDDIE BOOTH	6	CUSTOM		O/S	G	N/A	N/A
B10	42" SINGLE SKILLS/KIDDIE BOOTH	11	CUSTOM		O/S	G	N/A	N/A
B11	24" DOUBLE SKILLS/KIDDIE BOOTH	0	CUSTOM		O/S	G	N/A	N/A
B12	24" SINGLE SKILLS/KIDDIE BOOTH	0	CUSTOM		O/S	G	N/A	N/A
B13	72" BENCH	3	CUSTOM		O/S	G	N/A	N/A
B14								
B15								
B16								
B17	60" DOUBLE SHOWROOM/DINING BOOTH	10	CUSTOM		O/S	G	N/A	N/A
B18	60" SINGLE SHOWROOM/DINING BOOTH	2	CUSTOM		O/S	G	N/A	N/A
B19	48" DOUBLE SHOWROOM/DINING BOOTH	3	CUSTOM		O/S	G	N/A	N/A
B20	48" SINGLE SHOWROOM/DINING BOOTH	1	CUSTOM		O/S	G	N/A	N/A
B21	42" DOUBLE SHOWROOM/DINING BOOTH	1	CUSTOM		O/S	G	N/A	N/A
B22	42" SINGLE SHOWROOM/DINING BOOTH	2	CUSTOM		O/S	G	N/A	N/A
B23	24" DOUBLE SHOWROOM/DINING BOOTH	0	CUSTOM		O/S	G	N/A	N/A
B24	24" SINGLE SHOWROOM/DINING BOOTH	0	CUSTOM		O/S	G	N/A	N/A
B25	36" DOUBLE SHOWROOM/DINING BOOTH	0	CUSTOM		O/S	G	N/A	N/A
B26	36" SINGLE SHOWROOM/DINING BOOTH	0	CUSTOM		O/S	G	N/A	N/A

TABLES

T01								
T02	60" BOOTH TABLE SKILLS/KIDDIE	7	CUSTOM		O/S	G	N/A	N/A
T03	48" BOOTH TABLE SKILLS/KIDDIE	0	CUSTOM		O/S	G	N/A	N/A
T04	42" BOOTH TABLE SKILLS/KIDDIE	11	CUSTOM		O/S	G	N/A	N/A
T05	24" BOOTH TABLE SKILLS/KIDDIE	0	CUSTOM		O/S	G	N/A	N/A
T06								
T07	72"/60" BOOTH TABLE SKILLS/KIDDIE	0	CUSTOM		O/S	G	N/A	N/A
T08	60"/48" BOOTH TABLE SKILLS/KIDDIE	0	CUSTOM		O/S	G	N/A	N/A
T09	60"/42" BOOTH TABLE SKILLS/KIDDIE	1	CUSTOM		O/S	G	N/A	N/A
T10	48"/24" BOOTH TABLE SKILLS/KIDDIE	0	CUSTOM		O/S	G	N/A	N/A
T11	42"/24" BOOTH TABLE SKILLS/KIDDIE	5	CUSTOM		O/S	G	N/A	N/A
T12								
T13								
T14	42" x 28" FREESTANDING TABLE	38	CUSTOM		O/S	G	N/A	N/A
T15	60" x 28" FREESTANDING TABLE	5	CUSTOM		O/S	G	N/A	N/A
T16	60" BOOTH TABLE SHOWROOM/DINING	10	CUSTOM		O/S	G	N/A	N/A
T17	48" BOOTH TABLE SHOWROOM/DINING	0	CUSTOM		O/S	G	N/A	N/A
T18	42" BOOTH TABLE SHOWROOM/DINING	0	CUSTOM		O/S	G	N/A	N/A
T19	24" BOOTH TABLE SHOWROOM/DINING	0	CUSTOM		O/S	G	N/A	N/A
T20								
T21	72"/60" BOOTH TABLE SHOWROOM/DINING	0	CUSTOM		O/S	G	N/A	N/A
T22	60"/48" BOOTH TABLE SHOWROOM/DINING	0	CUSTOM		O/S	G	N/A	N/A
T23	60"/42" BOOTH TABLE SHOWROOM/DINING	2	CUSTOM		O/S	G	N/A	N/A
T24	48"/24" BOOTH TABLE SHOWROOM/DINING	0	CUSTOM		O/S	G	N/A	N/A
T25	42"/24" BOOTH TABLE SHOWROOM/DINING	1	CUSTOM		O/S	G	N/A	N/A
T26	48"/36" BOOTH TABLE SHOWROOM/DINING	1	CUSTOM		O/S	G	N/A	N/A

ALBUQUERQUE BUILDING & SAFETY
SEP-2 0 1999
PLAN CHECK SECTION

C.T. CHANG AIA
910 WEST EILDRS BLVD. #110
EMLESS, TEXAS 76040

STATE OF NEW MEXICO
C.T. CHANG
No. 3353
REGISTERED ARCHITECT

B&W BURSON & WILLIAMS
PROJECT ADMINISTRATION

CHUCK E. CHEESE'S PIZZA #332 - ALBUQUERQUE, NEW MEXICO
4416 WYOMING BLVD.NE. - ALBUQUERQUE, NEW MEXICO - 87111
CEC ENTERTAINMENT INC.
4441 WEST AIRPORT FREEWAY
IRVING, TEXAS 75062

FLOOR PLAN

Date 07/28/99

Revisions

Project Number 98-180

Sheet Number A1 of 05

THESE DOCUMENTS ARE THE SOLE PROPERTY OF CEC ENTERTAINMENT, INC. ANY REPRODUCTION OR UNAUTHORIZED USE OF THESE DOCUMENTS WITHOUT THE EXPRESS WRITTEN PERMISSION OF THE ARCHITECT AND CEC ENTERTAINMENT, INC. IS PROHIBITED.

PLAN SHOT TWICE
ONCE ON LIGHT
ONCE ON DARK

CITY OF ALBUQUERQUE
THIS MICROIMAGE IS THE BEST POSSIBLE REPRODUCTION DUE TO THE POOR QUALITY OF THE ORIGINAL DOCUMENT.

R# 79 DATE 1-31-01 OP ESP

CITY OF ALBUQUERQUE

This microimage is certified to be a complete and accurate copy of the original as it appears in the files of the **Planning Department** and was created in the normal course of business.

The photographic process used meets the Basic Microfilm Standards of the National Micrographics Association (MS115-1977)

Richard Gritsch
DIRECTOR

Margaret D. Garcia
NOTARY PUBLIC
Commission expires: 10/22/2001

D 2 C 20 B 10 12

CITY OF ALBUQUERQUE

C D

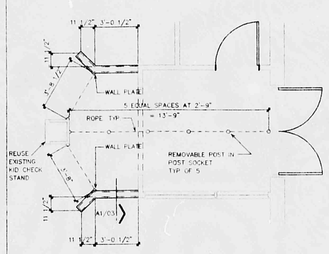

G.C. TO PROVIDE HARDWARE, STATION AND ROPE FOR KID CHECK AREA AS SHOWN

CORE DRILL 2 1/4" DIAMETER HOLES 4 3/4" DEEP FOR POST SOCKETS

ALL ITEMS HAVE BRASS FINISH UNLESS NOTED OTHERWISE

REGAL REMOVABLE POST (BLACK IRON NATURAL FINISH) (INCLUDES CROWN AND BASE)	5	BR-7
ROPE 3'-9" W/ SWAY-RED	2	BR-8
ROPE 2'-9" W/ SWAY RED	5	BR-8
WALL PLATE	2	BR-9

G.C. IS RESPONSIBLE FOR VERIFYING ALL ROPES, SIZES AND DIMENSIONS BEFORE ORDERING OR DRILLING

02 ENLARGED ENTRY

SCALE: 1/4" = 1'-0"

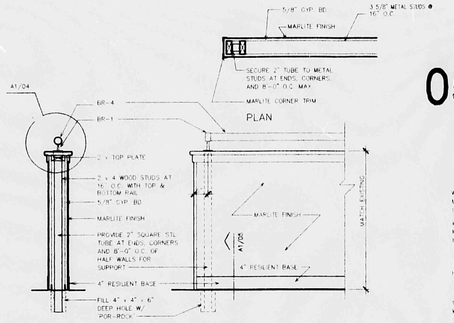

03 TYPICAL HALF WALL

SCALE: 3/4" = 1'-0"

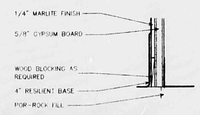

05 BASE DETAIL

SCALE: 3" = 1'-0"

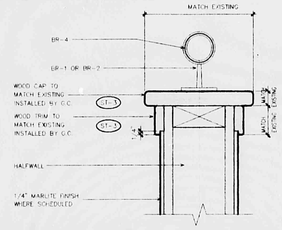

04 OAK CAP AT HALF WALL

SCALE: 3"=1'-0"

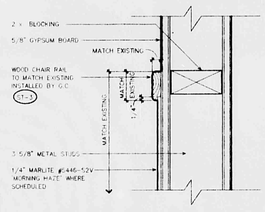

06 CHAIR RAIL

SCALE: 3" = 1'-0"

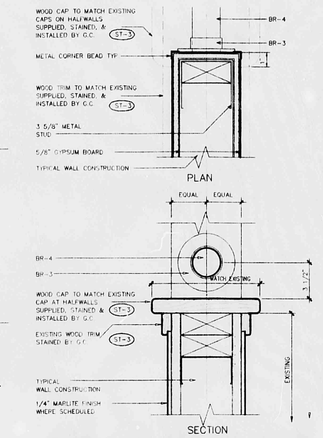

07 WALL OPENING DETAIL

SCALE: 3"=1'-0"

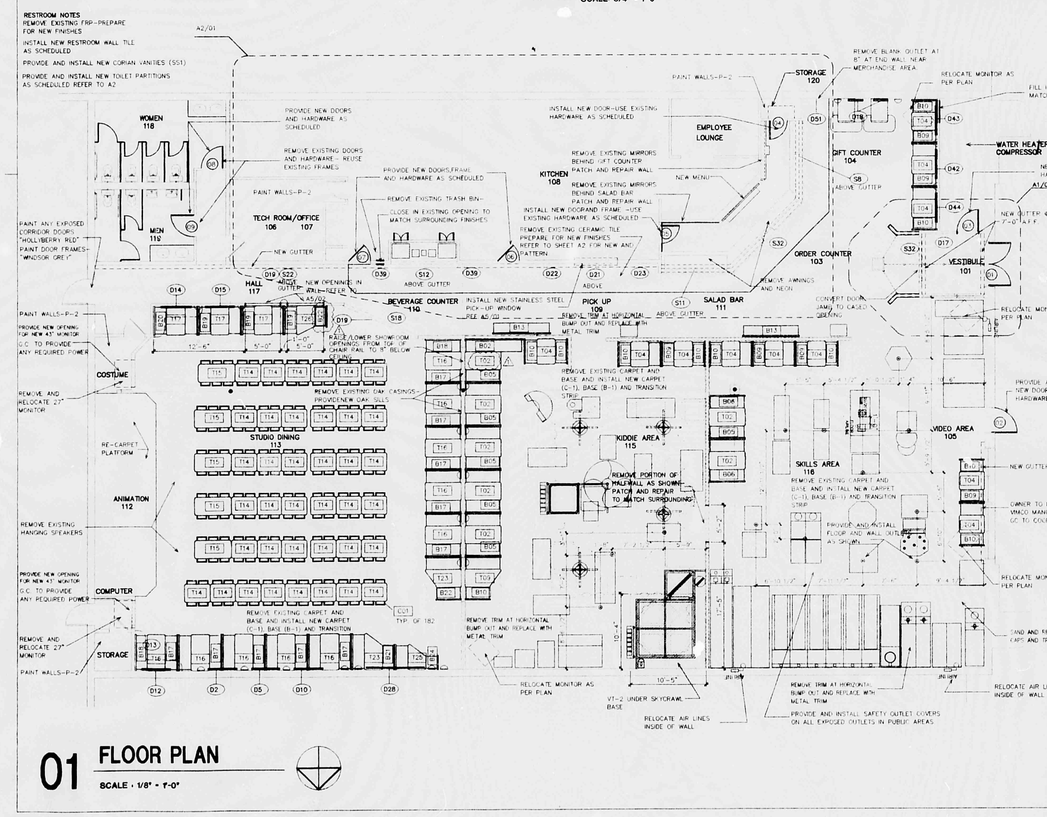

01 FLOOR PLAN

SCALE: 1/8" = 1'-0"

GENERAL NOTES

1. GENERAL CONTRACTOR RESPONSIBLE FOR RECEIVING, UNLOADING, AND INSPECTION AT TIME OF DELIVERY. REPORT ANY DAMAGE TO OWNER, AT TIME OF DELIVERY
2. NOT USED
3. GENERAL CONTRACTOR RESPONSIBLE FOR COORDINATION OF SECURITY SYSTEM. CONTACT OWNER FOR NAME OF SECURITY REPRESENTATIVE
4. GENERAL CONTRACTOR SHALL PROVIDE AND INSTALL CURB AS REQUIRED FOR ROOF MOUNTED CONDENSER UNIT. GENERAL CONTRACTOR SHALL PROVIDE AND INSTALL ALL NECESSARY ELECTRICAL SERVICE TO WALK-IN COOLER, AND RELATED REFRIGERATION EQUIPMENT. COORDINATE ANY ROOF ALTERATIONS WITH APPROVED ROOFING CONTRACTOR
5. REFRIGERATION SERVICED IS RESPONSIBLE FOR ALL PRE-CHARGED LINE WORK, AND EQUIPMENT START-UP ON WALK-IN COOLER AND ICE MACHINE. GENERAL CONTRACTOR TO COORDINATE WITH OWNER'S TECHNICAL ADVISER ON CHARGED AIR REQUIREMENTS AND LOCATIONS
6. G.C. WILL INSTALL WIRE ABOVE CEILING & IN WALL FOR SOUND SYSTEM. OWNER WILL PROVIDE ALL SPEAKER WIRE. OWNER WILL FURNISH AND INSTALL ALL SPEAKERS, & MAKE FINAL CONNECTIONS AT SPEAKERS
7. G.C. TO INSTALL WATER FILTER SYSTEM AS SHOWN ON PLANS
8. PRIZE SHELVING PACKAGE TO INCLUDE (4) EA 1'-0" x 10" RED SHELVES W/ (5) BRACKETS EACH SHELF (4) EA 4'-0" x 10" GREEN SHELVES W/ (2) BRACKETS EACH SHELF (4) EA 3'-0" x 10" BLUE SHELVES W/ (2) BRACKETS EACH SHELF (6) EA 2'-0" x 10" YELLOW SHELVES W/ (2) BRACKETS EACH SHELF
9. MOUNT S.S. COFFEE SHELF AT 32" A.F.F., PROVIDE OUTLET AT 36" A.F.F., DRAIN TO FLOOR SINK BELOW (FOR COFFEE AND BEER FAN)
10. REMOVE ALL EXISTING HORIZONTAL AND VERTICAL OAK TRIM. INSTALL METAL CORNER TRIM. PATCH AND REPAIR TO MATCH SURROUNDING FINISHES
11. REMOVE EXISTING PIZZA CIRCLES. PATCH AND REPAIR WALLS TO MATCH SURROUNDING FINISHES
12. SAND AND RESEAL ALL EXISTING OAK CAPS AND TRIMS
13. PRIME AND PAINT ALL EXISTING OAK AND BUFF MARLITE P-5 REFER TO SHEET A2
14. REMOVE EXISTING VINYL CHECKS. PATCH AND REPAIR WALL TO MATCH SURROUNDING FINISHES
15. G.C. TO INSTALL WIRING FOR NEW OWNER SUPPLIED SOUND SYSTEM THROUGHOUT NEW BOSE SYSTEM IN THE SHOWROOM
16. G.C. TO INSTALL NON MOTORIZED "VMCO" SHADES ON ALL EXTERIOR WINDOWS
17. G.C. TO VERIFY THAT ALL EXISTING DITEK HARDWARE ARE IN WORKING ORDER
18. OWNER TO DRY CLEAN EXISTING STAGE CURTAINS
19. INSTALL BLACK IRON RAILS WITH BRASS FITTINGS ON ALL HALF-WALLS REFER TO A1/05
20. MAINTENCE IS TO VERIFY THE CONDITION OF ALL A/C MECHANICAL UNITS, ICE MACHINES, MAKE TABLES, AND SALAD BAR REFRIGERATOR
21. SECURE ALL THERMOSTATS TO WALL OR REPLACE AS NECESSARY
22. PROVIDE AND INSTALL (3) NEW RECESSED FIRE EXTINGUISHER CABINETS--LOCATE AS PER FIRE MARSHAL

M	MILLWORK
K	KITCHEN
V	VENDOR
O	OWNER
G	GENERAL CONTRACTOR
S	SUPPLIER
N/A	NOT APPLICABLE

SEATING		AREA	
SHOWROOM:	250	SHOWROOM:	2,467
KIDDIE:	37	KIDDIE:	1,556
SKILLS:	28	SKILLS:	1,938
OTHER:	18	OTHER:	4,105
TOTAL:	333	TOTAL:	10,076 SQ.FT

ADDITIONAL EQUIPMENT & MILLWORK

MARK	DESCRIPTION	QTY	MANUFACTURER/MODEL NUMBER	REMARKS	FURNISHED	INSTALLED	HOOK-UP	START-UP
A02	SODA AND ICE DISPENSER	2	COKE VENDOR		V	V/G	V	V
A03								
A05	TEA DISPENSER	1	COKE VENDOR	(BLACK BOY FILTERS TO REMOTE OVER UNDERCOUNTERS	V	V/G	V	V
A14	EXHAUST HOOD SYSTEM	1	CAPTIVAIRE MODEL #6500SP	WITH MAKE-UP AIR AND FAN INCLUDES CURBS DUCTWORK BY G.C.	S	G	G	G
A20	SANDWICH TABLE	1	DELFIELD #4048-8	REFRIGERATED WORK TABLE	S	G	G	N/A
A81	ICE ACCESS DOORS	2	CUSTOM FABRICATED		G	G	N/A	N/A
M01								
M02	CUP CADDY	1	CUSTOM		O/M	G	N/A	N/A
M03	PRIZE CADDY	1	CUSTOM		O/M	G	N/A	N/A
M04	PRIZE CADDY SHELVING	1 SET	CUSTOM	REFER TO NOTE 8	O/M	G	N/A	N/A
M05	TRASH UNIT BOXES	1	CUSTOM		O/M	G	N/A	N/A
M06	TICKET SHELF	2	CUSTOM		O/M	G	N/A	N/A
M07	PAGINET STAND	1	CUSTOM		O/M	G	N/A	N/A

CHAIRS

MARK	DESCRIPTION	QTY	MANUFACTURER/MODEL NUMBER	REMARKS	FURNISHED	INSTALLED	HOOK-UP	START-UP
C1	CHAIRS	182	MTS		O/S	G	N/A	N/A
C2								
C3								
C4	EMPLOYEE STOOLS	0	MODERN LEATHERETTE MOUP		O/S	G	N/A	N/A

BOOTHS

B01								
B02	96" SINGLE SKILLS/KIDDIE BOOTH	1	CUSTOM		O/S	G	N/A	N/A
B03	84" SINGLE SKILLS/KIDDIE BOOTH	0	CUSTOM		O/S	G	N/A	N/A
B04	72" SINGLE SKILLS/KIDDIE BOOTH	0	CUSTOM		O/S	G	N/A	N/A
B05	60" DOUBLE SKILLS/KIDDIE BOOTH	6	CUSTOM		O/S	G	N/A	N/A
B06	60" SINGLE SKILLS/KIDDIE BOOTH	2	CUSTOM		O/S	G	N/A	N/A
B07	48" DOUBLE SKILLS/KIDDIE BOOTH	0	CUSTOM		O/S	G	N/A	N/A
B08	48" SINGLE SKILLS/KIDDIE BOOTH	0	CUSTOM		O/S	G	N/A	N/A
B09	42" DOUBLE SKILLS/KIDDIE BOOTH	6	CUSTOM		O/S	G	N/A	N/A
B10	42" SINGLE SKILLS/KIDDIE BOOTH	11	CUSTOM		O/S	G	N/A	N/A
B11	24" DOUBLE SKILLS/KIDDIE BOOTH	0	CUSTOM		O/S	G	N/A	N/A
B12	24" SINGLE SKILLS/KIDDIE BOOTH	0	CUSTOM		O/S	G	N/A	N/A
B13	72" BENCH	2	CUSTOM		O/S	G	N/A	N/A
B14								
B15								
B16								
B17	60" DOUBLE SHOWROOM/DINING BOOTH	10	CUSTOM		O/S	G	N/A	N/A
B18	60" SINGLE SHOWROOM/DINING BOOTH	2	CUSTOM		O/S	G	N/A	N/A
B19	48" DOUBLE SHOWROOM/DINING BOOTH	3	CUSTOM		O/S	G	N/A	N/A
B20	48" SINGLE SHOWROOM/DINING BOOTH	1	CUSTOM		O/S	G	N/A	N/A
B21	42" DOUBLE SHOWROOM/DINING BOOTH	1	CUSTOM		O/S	G	N/A	N/A
B22	42" SINGLE SHOWROOM/DINING BOOTH	2	CUSTOM		O/S	G	N/A	N/A
B23	24" DOUBLE SHOWROOM/DINING BOOTH	0	CUSTOM		O/S	G	N/A	N/A
B24	24" SINGLE SHOWROOM/DINING BOOTH	1	CUSTOM		O/S	G	N/A	N/A
B25	96" DOUBLE SHOWROOM/DINING BOOTH	0	CUSTOM		O/S	G	N/A	N/A
B26	96" SINGLE SHOWROOM/DINING BOOTH	0	CUSTOM		O/S	G	N/A	N/A

TABLES

T01								
T02	60" BOOTH TABLE SKILLS/KIDDIE	7	CUSTOM		O/S	G	N/A	N/A
T03	48" BOOTH TABLE SKILLS/KIDDIE	0	CUSTOM		O/S	G	N/A	N/A
T04	42" BOOTH TABLE SKILLS/KIDDIE	11	CUSTOM		O/S	G	N/A	N/A
T05	24" BOOTH TABLE SKILLS/KIDDIE	0	CUSTOM		O/S	G	N/A	N/A
T06								
T07	72"/60" BOOTH TABLE SKILLS/KIDDIE	0	CUSTOM		O/S	G	N/A	N/A
T08	60"/48" BOOTH TABLE SKILLS/KIDDIE	0	CUSTOM		O/S	G	N/A	N/A
T09	60"/42" BOOTH TABLE SKILLS/KIDDIE	1	CUSTOM		O/S	G	N/A	N/A
T10	48"/24" BOOTH TABLE SKILLS/KIDDIE	0	CUSTOM		O/S	G	N/A	N/A
T11	42"/24" BOOTH TABLE SKILLS/KIDDIE	5	CUSTOM		O/S	G	N/A	N/A
T12								
T13								
T14	42" x 28" FREESTANDING TABLE	38	CUSTOM		O/S	G	N/A	N/A
T15	60" x 28" FREESTANDING TABLE	5	CUSTOM		O/S	G	N/A	N/A
T16	60" BOOTH TABLE SHOWROOM/DINING	10	CUSTOM		O/S	G	N/A	N/A
T17	48" BOOTH TABLE SHOWROOM/DINING	0	CUSTOM		O/S	G	N/A	N/A
T18	42" BOOTH TABLE SHOWROOM/DINING	0	CUSTOM		O/S	G	N/A	N/A
T19	24" BOOTH TABLE SHOWROOM/DINING	0	CUSTOM		O/S	G	N/A	N/A
T20								
T21	72"/60" BOOTH TABLE SHOWROOM/DINING	0	CUSTOM		O/S	G	N/A	N/A
T22	60"/48" BOOTH TABLE SHOWROOM/DINING	0	CUSTOM		O/S	G	N/A	N/A
T23	60"/42" BOOTH TABLE SHOWROOM/DINING	2	CUSTOM		O/S	G	N/A	N/A
T24	48"/24" BOOTH TABLE SHOWROOM/DINING	0	CUSTOM		O/S	G	N/A	N/A
T25	42"/24" BOOTH TABLE SHOWROOM/DINING	1	CUSTOM		O/S	G	N/A	N/A
T26	48"/36" BOOTH TABLE SHOWROOM/DINING	1	CUSTOM		O/S	G	N/A	N/A

ALBUQUERQUE BUILDING & SAFETY
SEP 20 1999
PLAN REVIEW SECTION

THESE DOCUMENTS ARE THE SOLE PROPERTY OF CEC ENTERTAINMENT, INC. ANY COPYING OR USE OF THESE DOCUMENTS FOR ANY PURPOSE OTHER THAN CONSTRUCTION OF THIS PROJECT WITHOUT THE PRIOR WRITTEN PERMISSION OF THE ARCHITECT AND CEC ENTERTAINMENT, INC. IS PROHIBITED.

C.T. CHANG AIA
1010 WEST EULESS BLVD., #110
EULESS, TEXAS 76040

STATE OF NEW MEXICO
C.T. CHANG
No. 3353
REGISTERED ARCHITECT
9/15/99

B&W BURSON AND WILLIAMS
PROJECT ADMINISTRATOR

CHUCK E. CHEESE'S PIZZA #332 - ALBUQUERQUE, NEW MEXICO
4498 WYOMING BLVD.NE - ALBUQUERQUE, NEW MEXICO - 87111

CEC ENTERTAINMENT INC.
4441 WEST AIRPORT FREEWAY
IRVING, TEXAS. 75062

FLOOR PLAN

Date: 07/28/99

Revisions

Project Number: 98-180

Sheet Number: A1 of 05

PLAN SHOT TWICE
ONCE ON LIGHT
ONCE ON DARK

CITY OF ALBUQUERQUE
THIS MICROIMAGE IS THE BEST POSSIBLE REPRODUCTION DUE TO THE POOR QUALITY OF THE ORIGINAL DOCUMENT.

R# 79 DATE 1-31-01 OP EP

CITY OF ALBUQUERQUE

This microimage is certified to be a complete and accurate copy of the original as it appears in the files of the **Planning Department** and was created in the normal course of business.

The photographic process used meets the Basic Microfilm Standards of the National Micrographics Association (MS115-1977)

Richard Griffith
DIRECTOR

Margaret D. Garcia
NOTARY PUBLIC
Commission expires: 10/22/2001

D C B 12

CITY OF ALBUQUERQUE

D 2 C 20 b 10 12

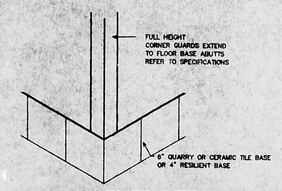

04 CORNER DETAIL
SCALE: 1 1/2" = 1'-0"

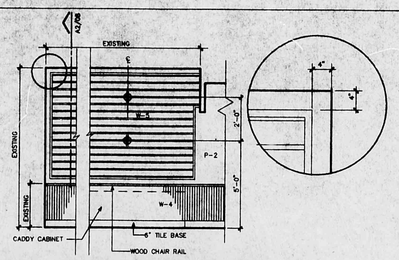

07 GIFT SHOP ELEVATION
SCALE: 1/4" = 1'-0"

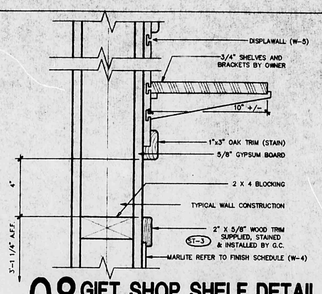

08 GIFT SHOP SHELF DETAIL
SCALE: 3" = 1'-0"

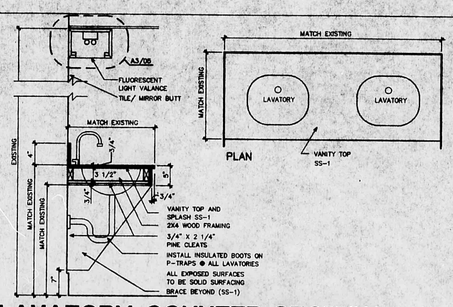

09 LAVATORY COUNTER SECTION
SCALE: 3/4" = 1'-0"

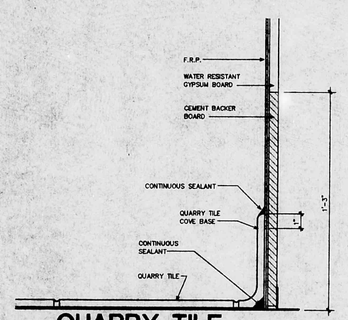

10 QUARRY TILE COVE BASE DETAIL
SCALE: 6" = 1'-0"

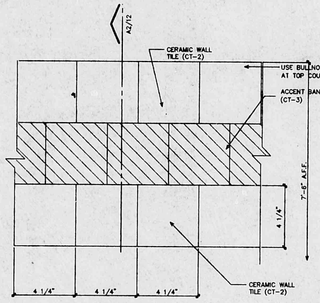

11 RR. TILE CHECKS
SCALE: 3" = 1'-0"

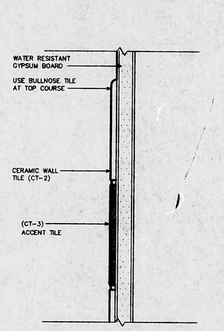

12 TILE DETAIL AT RESTROOM
SCALE: 6" = 1'-0"

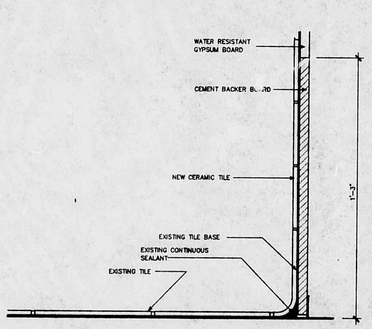

13 CERAMIC TILE COVE BASE DETAIL
SCALE: 3" = 1'-0"

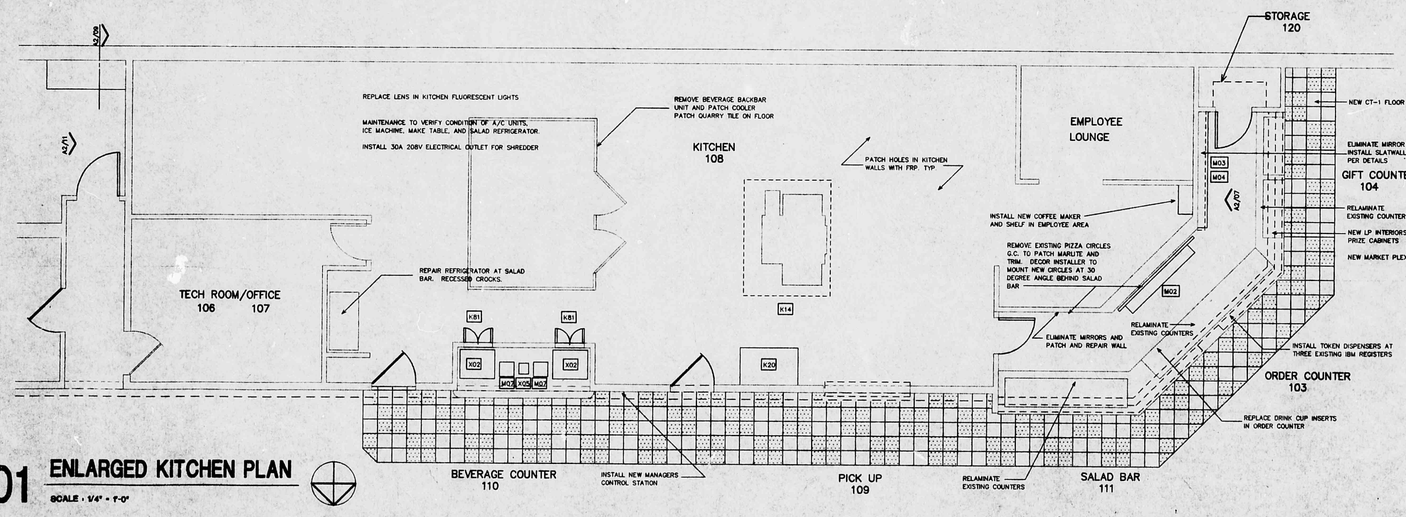

01 ENLARGED KITCHEN PLAN
SCALE: 1/4" = 1'-0"

FINISH KEY

03300 CONCRETE
E EXPOSED CONCRETE - SEALED

05720 ORNAMENTAL METAL LAM INDUSTRIES, INC.
SR-1 FLUSH END POST, 2", CLEAR COAT BRASS
SR-2 FLUSH CENTER POST, 2", CLEAR COAT BRASS
SR-3 2" x 4" WALL FLANGE, CLEAR COAT BRASS
SR-4 2" DIAMMETER TUBING, WRINKLE BLACK
SR-5 2" DIAMETER TUBING, UNFINISHED OAK
SR-6 FLUSH END CAP FOR WOOD, CLEAR COAT BRASS
SR-7 REGAL REMOVABLE POST, WRINKLE BLACK POST WITH BRASS GROMM AND BASE
SR-8 VELOUR COVERED ROPE, CARDINAL WITH CHAIN CORE. INCLUDES BRASS ROPE SNAP HOOK (#00-830) FOR EACH SECTION
SR-9 WALL PLATE, BRASS

06410 PLASTIC LAMINATE
LP-1 WILSONART "HOLLYBERRY" RED GRID D-307-78

06410 SOLID SURFACING
SS-1 WILSONART "GIBRALTER" 1572-SL ANTIQUE WHITE

09260 GYPSUM DRYWALL
GP-1 TO PAINT (refer to Painting for texture)
GP-2 NOT USED

09311 CERAMIC TILE
CT-1 TYPE: FLOOR TILE
SIZE: 12" x 12" LAID IN 24" x 24" PATTERN AS SHOWN
TILES: CROSSVILLE #A215 EMPRESS WHITE CP2 and #A850 GRAPHITE CP1
BASE: 6" HIGH GROVE - GRAPHITE
GROUT: MFGR: CUSTOM BUILDING PRODUCTS "WINTER GREY"
CT-2 TYPE: WALL TILE
SIZE: 4 1/4" x 4 1/4"
TILES: UNITED STATES CERAMICS TILE U078 ALMOND
GROUT: MFGR: CUSTOM BUILDING PRODUCTS "SAIL WHITE"
CT-3 TYPE: WALL TILE ACCENT BAND
SIZE: 4 1/4" x 4 1/4"
TILES: UNITED STATES CERAMICS TILE U155 RED
GROUT: MFGR: CUSTOM BUILDING PRODUCTS "SAIL WHITE"

09330 QUARRY TILE
QT-1 6" X 6" QUARRY TILE
FINISH: AMERICAN OLEAN "CANYON RED" ABR. SURFACE W/ BLACK GROUT
QT-2 6" X 6" QUARRY TILE
FINISH: AMERICAN OLEAN "CANYON RED" DBL. ABR. SURFACE W/ BLACK GROUT

09510 ACOUSTICAL LAY-IN CEILINGS
LT-1 ARMSTRONG #1718HA, FINE FISSURED SECOND LOOK II 24" x 48" x 3/4" WITH XL HA 15/16" EXPOSED TEE SYSTEM
LT-2 ARMSTRONG #670 VINYL FACED GLIP 24" x 48" x 1/2" WITH PRELUDE XL WHITE GRID
LT-3 LT-2 PAINT TO MATCH LT-1
GRID TO MATCH CEILING TILE COLOR IN PUBLIC AREAS

09660 RESILIENT TILE
VT-1 ARMSTRONG PREMIUM EXCELON TILE, 12" X 12" STONETEX PEBBLE GRAY
VT-2 ARMSTRONG PREMIUM EXCELON TILE, 12" X 12" STONETEX #52144 COAL BLACK

09678 RESILIENT BASE
B-1 4" HIGH COVE - BURKE 643P - "CHARCOAL"
B-2 12" TREAD - BURKE 642M - "SILVER"

09687 CARPET
C-1 HARBINGER CARPET "CEC PASSION" SUPPLIED BY OWNER
C-2 HUEGA SUPERFLOOR "S" 18" X 18" TILE BY J. ARNOLD
214-742-1745 COLOR: 1359 (IN VESTIBULE ONLY)

09900 PAINT/STAINS
All products listed are available thru Sherwin Williams. National Account Manager Marie Buckland 214-457-9181

VERIFY ALL EXISTING COLORS PRIOR TO STARTING ANY WORK TO 214-821-8100.
ALL PRODUCTS LISTED SHALL COMPLY WITH STATE VOC GUIDELINES

P-1 **Hollyberry Red** custom formula: used on exposed metal columns and older non-prefinished front doors (not for new powder-coat finish entrance doors).
PRIMER ProMark metal primer
PAINT Base: Industrial Enamel Safety Red B54B38
B54K38-Hollyberry Red-Ind.Enamel-Safety Red Base, Base Colorant, QH-40, QR-32, TR-16
Note: On older remodeled stores some interior doors also use this color in those cases, prep for re-paint with scuff sand (2 coats)

P-2 **Lighthouse** DR-1063 used on upper walls, fire exit doors and frames.
TEXTURE Drywall Texture medium orange peel (verify/approve)
PRIMER Drywall Primer ProMar 200 latex primer E17W200 (1 coat)
PAINT Drywall Paint ProMar 200 latex semi-gloss enamel B31W200 (2 coats)
Note: On fire exit doors and frames
Paint DTM acrylic coating B66-2003
(only in cases of rust or slick surface scuff sand and use KROMIK universal primer)

P-3 **Wonder Gray** S310D40 used on interior door frames
PAINT DTM acrylic coating B66-2002 (scuff sand and primer only as required)

P-4 **Oyster Shell** exterior custom color matching dryvit specification
PRIMER Loxon A24W200
PAINT formula base A-100 (extra/2 coats minimum)
DTM B66 W201-Oyster Shell same for A-100, Y3-9401, R2411, B141
on metals and flashing use KROMIK primer & DTM paint.

P-5 **Morning Haze** custom match to mattite of same name used only on remodels not for new construction.
PRIMER RM primer (1 coat)
PAINT formula base B34W200 alkyd enamel (semi gloss),
B31W201-Morning Haze, B1-3641, Y3-2241, R2-7, W9-3

P-6 **Pancake** exterior custom color matching dryvit specification
PRIMER Loxon A24W200
PAINT formula base A-100 (extra/2 coats)
DTM B66 W201-Pancake-Same for A-100, Y3-2582-4,B1-1

P-7 **Haze** custom match to Armstrong, ceiling grid and tile of same name.
(Used on remodels only, not for new construction)
PAINT B30 W 401, H1-2Y, P1-4

P-8 **Stones Throw** used on ceiling of Studio "C" shoe (new construction)
PAINT ProMar 200 interior latex flat paint (B30 W 200)

P-9 **Flat Black** used on backwall or enameled shoe
PAINT ProMar 400 flat latex (2 coats)

ST1 **Interior Oak** (low wall caps and window sills)
1ST COAT Sherwin Williams wood wiping stain (white wash) S64 W11 White
2ND COAT Sherwin Williams wood vinyl sealer T87 F3
3RD COAT Sherwood oak acrylic T75 C15
4TH COAT same as third coat

ST2 **Interior Oak** (mantle chair rail cap and misc.)
1ST COAT Sherwin Williams wood wiping stain (cherry) S64 R6 cherry with 4 oz. maroon oxide
2ND COAT Sherwin Williams wood vinyl sealer T87 F3
3RD COAT Sherwood oak acrylic T75 C15
4TH COAT same as third coat

ST3 **Interior Oak** (low wall caps, window stills and trim to match existing medium oak finish) (for remodels only)
1ST COAT M89/200 Pearwood stain (medium oak) Y3-36, R2-2Y,Y1-15,W1-4115.01-8
(finish coats same as above)

09971 FRP
W-2 .09 THK EMBOSSED Fiberglass Reinforced Panels - KEMLITE II FRP WHITE

09972 MARLITE WALL PANELS
W-4 1/4" MARLITE NO. 5446-52V "MORNING HAZE"
W-5 DISPLAY WALL - NO.2764 "CRYSTAL GREY"
CONTACT MARLITE/BILL MCCAULEY @ 817-481-4654

ALBUQUERQUE BUILDING & SAFETY
SEP 20 1999
PLAN CHECK SECTION

THESE DRAWINGS ARE THE SOLE PROPERTY OF C.T. CHANG AIA AND ARE NOT TO BE USED ON ANY OTHER PROJECTS. THEY ARE NOT TO BE LOANED, COPIED OR REPRODUCED WITHOUT THE WRITTEN CONSENT OF C.T. CHANG AIA. VISUAL CONTACT WITH THESE DRAWINGS SHALL CONSTITUTE PRIMA FACIE EVIDENCE OF ACCEPTANCE OF THESE RESTRICTIONS.

C.T. CHANG AIA

STATE OF NEW MEXICO
C.T. CHANG
No. 3457
REGISTERED ARCHITECT

B&W SHERWIN WILLIAMS
PRODUCT ADMINISTRATOR

CHUCK E. CHEESE'S PIZZA #332 - ALBUQUERQUE, NEW MEXICO
4416 WYOMING BLVD.NE. - ALBUQUERQUE, NEW MEXICO - 87111
ORG ENTERTAINMENT INC.
4441 WEST AIRPORT FREEWAY
IRVING, TEXAS. 75062

ENLARGED KITCHEN PLAN

Date 07/28/99

Revisions

Project Number 98-180

Sheet Number A2 of 05

PLAN SHOT TWICE
ONCE ON LIGHT
ONCE ON DARK

CITY OF ALBUQUERQUE
THIS MICROIMAGE IS THE BEST POSSIBLE REPRODUCTION DUE TO THE POOR QUALITY OF THE ORIGINAL DOCUMENT.

R# 79 DATE 1-31-01 OP KJP

CITY OF ALBUQUERQUE

This microimage is certified to be a complete and accurate copy of the original as it appears in the files of the Planning Department and was created in the normal course of business.

The photographic process used meets the Basic Microfilm Standards of the National Micrographics Association (MS115-1977)

Richard Getlich
DIRECTOR

Margaret D. Garcia
NOTARY PUBLIC

Commission expires: 10/22/2001

D 2 C 20 b 10 12

CITY OF ALBUQUERQUE

D

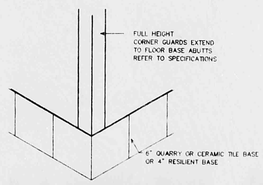

04 CORNER DETAIL
SCALE - 1 1/2" = 1'-0"

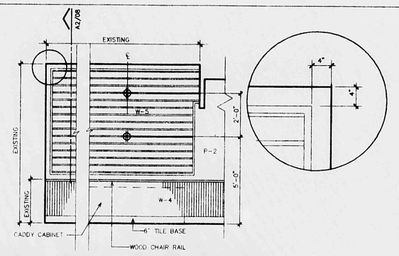

07 GIFT SHOP ELEVATION
SCALE: 1/4" = 1'-0"

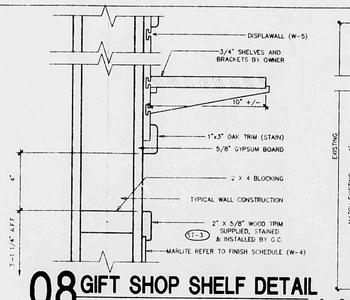

08 GIFT SHOP SHELF DETAIL
SCALE: 3" = 1'-0"

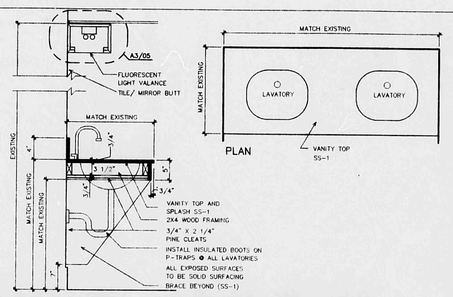

09 LAVATORY COUNTER SECTION
SCALE: 3/4" = 1'-0"

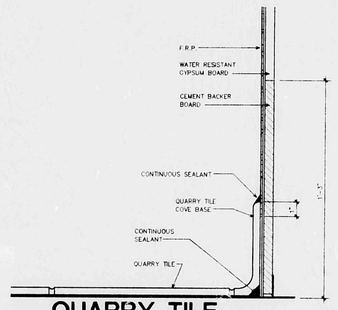

10 QUARRY TILE COVE BASE DETAIL
SCALE: 3" = 1'-0"

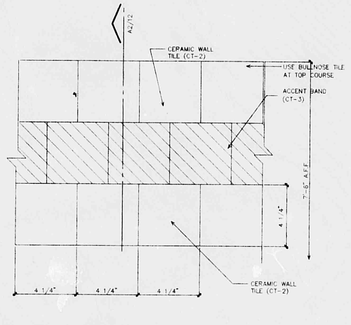

11 RR. TILE CHECKS
SCALE - 3" = 1'-0"

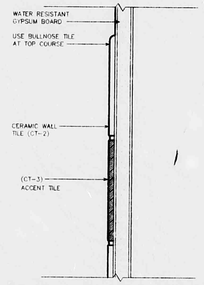

12 TILE DETAIL AT RESTROOM
SCALE - 6" = 1'-0"

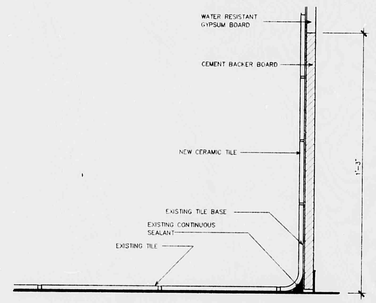

13 CERAMIC TILE COVE BASE DETAIL
SCALE - 3" = 1'-0"

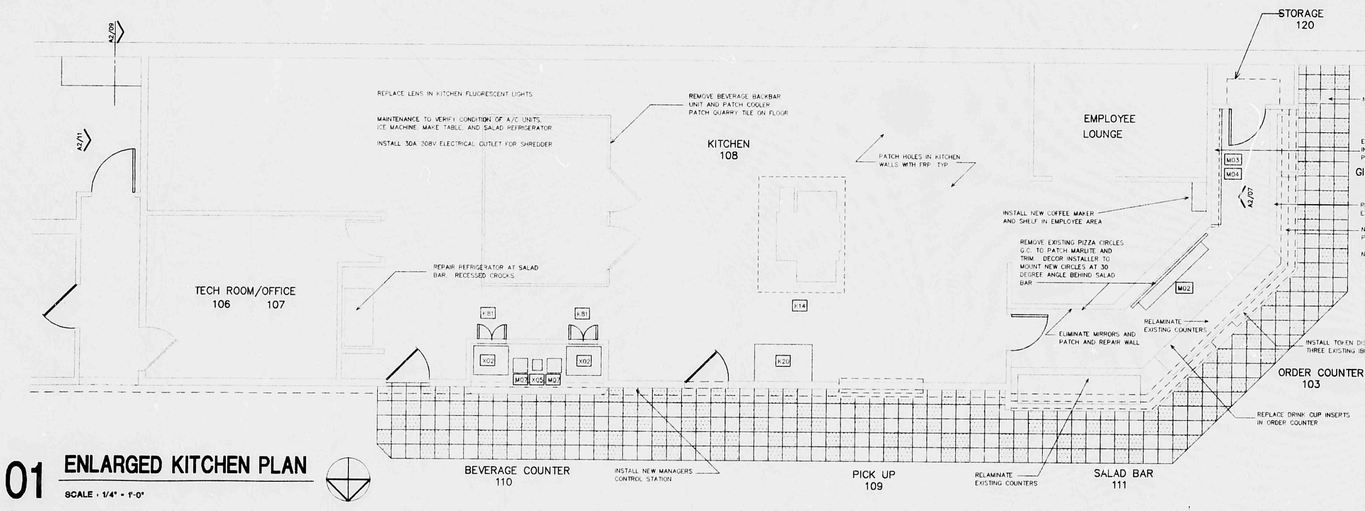

01 ENLARGED KITCHEN PLAN
SCALE - 1/4" = 1'-0"

FINISH KEY

03300 CONCRETE
E EXPOSED CONCRETE - SEALED

05720 ORNAMENTAL METAL LAVI INDUSTRIES, INC.
BR-1 FLUSH END POST, 2", CLEAR COAT BRASS
BR-2 FLUSH CENTER POST, 2", CLEAR COAT BRASS
BR-3 2" x 4" WALL FLANGE, CLEAR COAT BRASS
BR-4 2" DIAMMETER TUBING, WRINKLE BLACK
BR-5 2" DIAMETER TUBING, UNFINISHED OAK
BR-6 FLUSH END CAP FOR WOOD, CLEAR COAT BRASS
BR-7 REGAL REMOVABLE POST, WRINKLE BLACK POST WITH BRASS CROWN AND BASE
BR-8 VELOUR COVERED ROPE, CARDINAL WITH CHAIN CORE. INCLUDES BRASS ROPE SNAP HOOK (#00-930) FOR EACH SECTION
BR-9 WALL PLATE, BRASS

06410 PLASTIC LAMINATE
LP-1 WILSONART "HOLLYBERRY" RED GRID D-307-76

06410 SOLID SURFACING
SS-1 WILSONART "GIBRALTER" 1572-SL ANTIQUE WHITE

09260 GYPSUM DRYWALL
GP-1 TO PAINT (refer to Painting for texture)
GP-2 NOT USED

09311 CERAMIC TILE
CT-1 TYPE: FLOOR TILE
SIZE: 12" x 12" LAID IN 24" x 24" PATTERN AS SHOWN
TILES: CROSSVILLE #A215 EMPRESS WHITE CP2 and #A850 GRAPHITE CP1
BASE: 6" HIGH COVE - GRAPHITE
GROUT: MFGR. CUSTOM BUILDING PRODUCTS "WINTER GREY"
CT-2 TYPE: WALL TILE
SIZE: 4 1/4" x 4 1/4"
TILES: UNITED STATES CERAMICS TILE U078 ALMOND
GROUT: MFGR. CUSTOM BUILDING PRODUCTS "SAIL WHITE"
CT-3 TYPE: WALL TILE ACCENT BAND
SIZE: 4 1/4" x 4 1/4"
TILES: UNITED STATES CERAMICS TILE U733 RED
GROUT: MFGR. CUSTOM BUILDING PRODUCTS "SAIL WHITE"

09330 QUARRY TILE
QT-1 6" X 6" QUARRY TILE
FINISH: AMERICAN OLEAN "CANYON RED" ABR. SURFACE W/ BLACK GROUT
QT-2 6" X 6" QUARRY TILE
FINISH: AMERICAN OLEAN "CANYON RED" DBL. ABR. SURFACE W/ BLACK GROUT

09610 ACOUSTICAL LAY-IN CEILINGS
LT-1 ARMSTRONG #1761HA FINE FISSURED SECOND LOOK II 24" x 48" x 3/4" WITH XL HA 15/16" EXPOSED TEE SYSTEM
LT-2 ARMSTRONG #670 VINYL FACED GLIP 24" x 48" x 1/2" WITH PRELUDE XL WHITE GRID
LT-3 LT-2 PAINT TO MATCH LT-1
GRID TO MATCH CEILING TILE COLOR IN PUBLIC AREAS

09660 RESILIENT TILE
VT-1 ARMSTRONG PREMIUM EXCELON TILE, 12" X 12" STONETEX PEBBLE GRAY
VT-2 ARMSTRONG PREMIUM EXCELON TILE, 12" X 12" STONETEX #52144 COAL BLACK

09678 RESILIENT BASE
B-1 4" HIGH COVE - BURKE 642P - "CHARCOAL"
B-2 12" TREAD - BURKE 642M - "SILVER"

09697 CARPET
C-1 HARBINGER CARPET CEC PASSION SUPPLIED BY OWNER
C-2 HUECA SUPERFLOOR 5'-15" x 18" TILE BY J. ARNOLD
214-742-1745 COLOR: 1359 (IN VESTIBULE ONLY)

09900 PAINT/STAINS
All products listed are available thru Sherwin Williams National Account Manager Marvin Buckland 214-637-9181
VERIFY ALL EXISTING COLORS PRIOR TO STARTING ANY WORK. TO 214-821-9100.
ALL PRODUCTS LISTED SHALL COMPLY WITH STATE VOC GUIDELINES
P-1 Hollyberry Red custom formula: used on exposed metal columns and older non-prefinished front doors (not for new powder-coat finish entrance doors).
PRIMER K/KMR metal primer
PAINT Base: Industrial Enamel Safety Red B54K38
B54K38-Hollyberry Red-Ind.Enamel-Safety Red Base, Base Colorant, QV-40, QR-32, TW-16
Note: On site remodeled stores same exterior doors also use this color in those cases, prep for re-paint with scuff sand (2 coats)
P-2 Lightmoves SW-1063 used on upper walls, fire exit doors and frames.
TEXTURE Drywall Texture medium orange peel (verify/approve)
PRIMER Drywall Primer Prokar 200 latex primer B30W200 (1 coat)
PAINT Drywall Paint Prokar 200 latex semi-gloss enamel B31W200 (2 coats)
Note: On fire exit doors and frames
Paint DTM acrylic coating B66-2051
(only in cases of rust or slick surface scuff sand and use K/KMR universal primer)
P-3 Windsor Gray SW1040 used on interior door frames
PAINT DTM acrylic coating B66-2002 (scuff sand and primer only as required)
P-4 Oyster Shell exterior custom color matching drywit specification
PRIMER Loxon A24W300
PAINT formula base A-100 (satin/2 coats minimum)
DTM B66 W201-Oyster Shell same for A-100, 13-34-B1, B2+11, B1+1
on metals and flashing use K/KMR primer & DTM paint
P-5 Morning Haze custom match to marble of same name used only on remodels not for new construction
PRIMER KM primer (1 coat)
PAINT formula base B3M200 alkyd enamel (semi gloss).
B31W201-Morning Haze, B1+36+1, Y3+22+1, R2-7, W-5
P-6 Pancake exterior custom color matching drywit specification
PRIMER Loxon A24W300
PAINT formula base A-100 (satin/2 coats)
DTM B66 W201-Pancake-Same for A-100, Y3-28,R2-4,B1-1
P-7 Haze custom match to Armstrong, ceiling grid and tile of same name. (Used on remodels only, not for new construction)
PAINT B36 W 40, N1-21, P1-4
P-8 Stones Throw used on ceiling at Studio "C" show (new construction)
PAINT Prokar 200 interior latex flat paint (B30 W 200)
P-9 Flat Black used on backwall or animated show
PAINT Prokar 400 flat latex (2 coats)
ST1 Interior oak (low wall caps and window sills)
1ST COAT Sherwin Williams wood wiping stain (white wash) 564 W1 White
2ND COAT Sherwin Williams wood vinyl sealer T87 f 1
3RD COAT Sherwood cat acrylic T75 C15
4TH COAT same as third coat
ST2 Interior oak (marble chair rail cap and misc.)
1ST COAT Sherwin Williams wood wiping stain (cherry) 564 R6 cherry with 4 oz. maroon oxide
2ND COAT Sherwin Williams wood vinyl sealer T87 f 1
3RD COAT Sherwood cat acrylic T75 C15
4TH COAT same as third coat
ST3 Interior oak (low wall caps, window skills and trim to match existing medium oak finish) (for remodels only)
1ST COAT 448V200 Pearwood stain (medium oak) Y3-36, R2-2Y,Y1-16,W1-4116,G1-8
(finish coats same as above)

09971 FRP
W-2 09 THK EMBOSSED Fiberglas Reinforced Panels - KEMLITE - FRP WHITE

09972 MARLITE WALL PANELS
W-4 1/4" MARLITE NO. 5446-52W MORNING HAZE
W-5 DISPLAY WALL - NO.2764 "CRYSTAL GREY"
CONTACT MARLITE/BILL MCAULEY @ 617-481-4554

ALBUQUERQUE BUILDING & SAFETY
SEP 2 0 1999
PLAN CHECK RECEIVED

CHUCK E. CHEESE'S PIZZA #332
418 WYOMING BLVD.NE - ALBUQUERQUE, NEW MEXICO
CEC ENTERTAINMENT INC.
4441 WEST AIRPORT FREEWAY
IRVING, TEXAS. 75062

ENLARGED KITCHEN PLAN

THESE DOCUMENTS ARE THE SOLE PROPERTY OF CEC ENTERTAINMENT, INC. AND COPYING OR REPRODUCTION OF THESE PLANS FOR PURPOSE OTHER THAN CONSTRUCTION OF THIS PROJECT WITHOUT THE EXPRESS WRITTEN PERMISSION OF THE ARCHITECT AND CEC ENTERTAINMENT, INC. IS PROHIBITED

C.T. CHANG AIA
1010 WEST EULESS BLVD., #10
EULESS, TEXAS 76040

STATE OF NEW MEXICO
C.T. CHANG
NM 3853
REGISTERED ARCHITECT

B&W
BURSON AND WILLIAMS
PROJECT ADMINISTRATOR

Date 07/28/99

Revisions

Project Number 98-180

Sheet Number A2 of 05

PLAN SHOT TWICE
ONCE ON LIGHT
ONCE ON DARK

CITY OF ALBUQUERQUE
THIS MICROIMAGE IS THE BEST POSSIBLE REPRODUCTION DUE TO THE POOR QUALITY OF THE ORIGINAL DOCUMENT.

R= 752 DATE 1-31-01 OP EJP

CITY OF ALBUQUERQUE

This microimage is certified to be a complete and accurate copy of the original as it appears in the files of the **Planning Department** and was created in the normal course of business.

The photographic process used meets the Basic Microfilm Standards of the National Micrographics Association (MS115-1977)

Richard Griffith
DIRECTOR

Margaret D. Garcia
NOTARY PUBLIC

Commission expires: 10/22/2001

D C b 12

CITY OF ALBUQUERQUE

D

CODE ADMINISTRATION PLANS

ADD: 4418 WYOMING BLVD. N.E.

DES: REMODEL

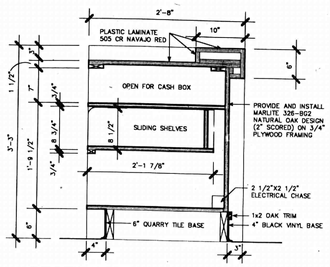

13 SECTION @ ORDER COUNTER

SCALE: 1" = 1'-0"

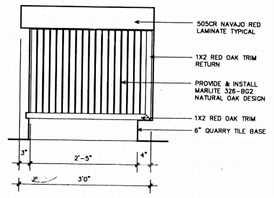

12 SALAD BAR ELEVATION – SIDE

SCALE: 3/4" = 1'-0"

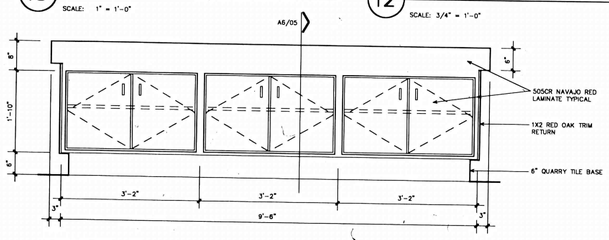

11 SALAD BAR ELEVATION – BACK

SCALE: 3/4" = 1'-0"

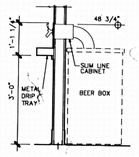

SECTION AT BEER BOX AND TAPS

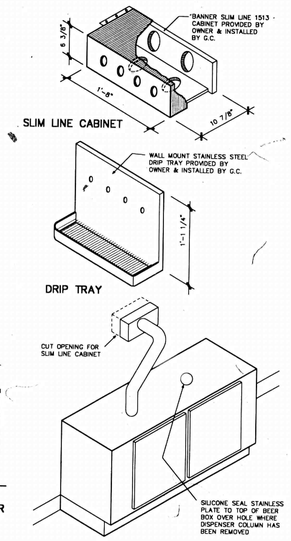

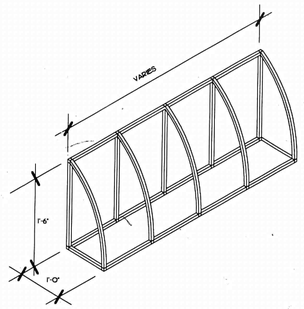

08 OUTSIDE WINDOW AWNING GUIDELINES

NO SCALE

OUTSIDE WINDOW AWNING INSTALLATION INSTRUCTIONS:

1. Connect frame together at x's using self tapping screws provided.
2. Determine height of awning over window using chalk line, mark wall.
3. Fasten awning to wall using wood screws or lagscrews with lead anchors.
4. Take canvas sliding through slot, which is mounted on top of frame center canvas on frame, pull down front two corners.
5. Lace awning to frame, starting from corners working your way to the center. If awning has wrinkles, re-lace pulling canvas tightly.
6. Using projection bars provided, mount to frame at pocket and to window frame, cutting bar to right length to make awning level.

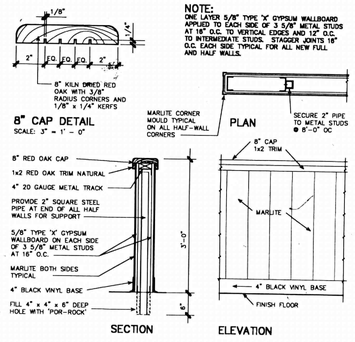

8" CAP DETAIL

SCALE: 3" = 1'-0"

NOTE:
ONE LAYER 5/8" TYPE 'X' GYPSUM WALLBOARD APPLIED TO EACH SIDE OF 3 5/8" METAL STUDS AT 16" O.C. TO VERTICAL EDGES AND 12" O.C. TO INTERMEDIATE STUDS. STAGGER JOINTS 16" O.C. EACH SIDE TYPICAL FOR ALL NEW FULL AND HALF WALLS.

05 TYPICAL HALF-WALL

SCALE: 3/4" = 1'-0"

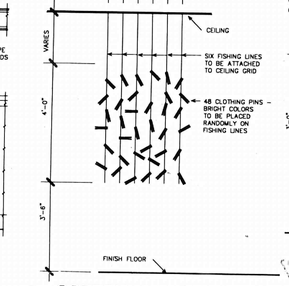

06 COTTON CANDY MOUNT

SCALE: 1/2" = 1'-0"

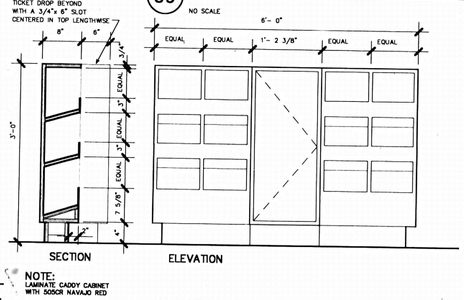

NOTE:
LAMINATE CADDY CABINET WITH 505CR NAVAJO RED

G.C. TO INSTALL CADDY CABINET UNDER GLASS SHELVES IN GIFT AREA.

CADDY CABINET TO BE: 6'-0" LONG

07 CADDY CABINET

SCALE: 1" = 1'-0"

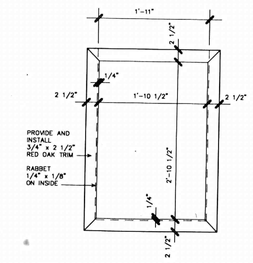

01 WALL FRAMES

SCALE: 1" = 1'-0"

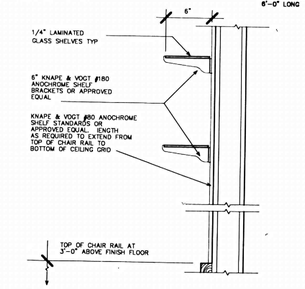

02 GIFT AREA SHELVING

SCALE: 1 1/2" = 1'-0"

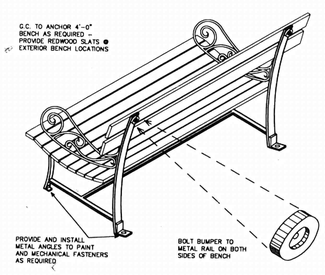

03 BENCH BUMPER DETAIL

NO SCALE

INSIDE AWNING WALL MOUNTED INSTRUCTIONS:

1. Connect frame using self tapping screws provided in frame.
2. Lifting ceiling panels, find wall studs, mark on outside wall on each stud center.
3. Slide canvas through slot mounted on top of frame. Raise canvas and frame to wall height.
4. Using conduit straps, put straps on head bar of awning at wall stud marks. Secure to stud using dry wall screws and washers.
5. Pull canvas tightly on frame.
6. Tie canvas to frame, starting at corners working way to center. If wrinkles develop, re-tie, pulling canvas tightly.

INSIDE AWNING CEILING MOUNT INSTALLATION INSTRUCTIONS:

1. Connect frames using self tapping screws provided in frame. Determine corner points on ceiling. Mount frame to ceiling using rigid conduit straps, with dry wall screws to ceiling grids. Using 1/2" EMT, cut 1/2" spacers to go between straps and ceiling grid if ceiling comes below grid work.
2. Slide canvas through slot, which is mounted on top of awning. Pull corners tightly. Starting at corner, tie to center. After canvas is tied, check for wrinkles. Re-tie with dry wall anchors if stud is not available.

NOTES:

1. When tieing, pull on canvas not on grommets. Grommets may pull out.
2. Always make sure canvas is centered on frame before tieing.

AWNING HARDWARE:

5/16 X 2" Woodscrews for exterior awning.

6" X 1-1/4" Drywall screws for interior awning.

3/16" flat washers to be used with all screws

Conduit straps for interior frames

1/2" Conduit spacers to use with conduit straps if ceiling panels come below ceiling grid work.

White drywall anchors to be used with conduit straps on end of awnings if studs are not available.

Lead anchors for exterior awnings if going in anything other than wood.

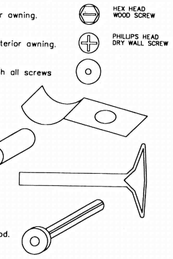

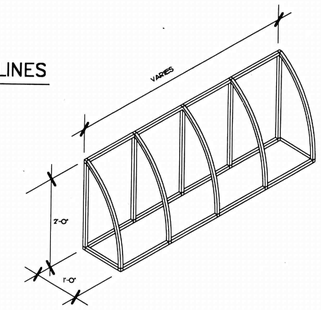

GENERAL SPECIFICATIONS FOR STEEL FRAMEWORK:

Welded Frames:
1. (a) The rib spacing for all bubbles, extended bubble and domes will be 15".
   (b) The horizontal members (projections) will be spaced 7' to 10'.
2. The frames will be made of EMT galvanized thin wall steel tubing 1/2" – 3/4" – 1-1/4" O.D.
3. The frames will be MIG welded.
4. (a) All welds will be wire brushed and ground to have a smooth finish.
   (b) All welds will be painted with Galvan or equal.

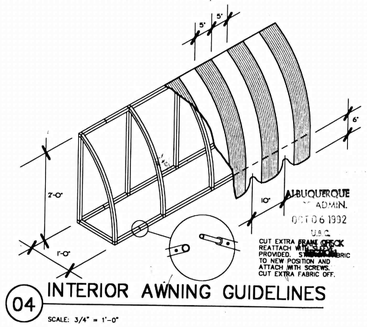

04 INTERIOR AWNING GUIDELINES

SCALE: 3/4" = 1'-0"

C. C. KOEHLER, CONSULTING ARCHITECT, A.I.A.

B&W BURSON AND WILLIAMS ARCHITECTS INC.
8303 Elmbrook • Dallas, Texas 75247 • 214/631-8774

STATE OF NEW MEXICO — CLEMENTS C. KOEHLER — 433 — REGISTERED ARCHITECT

CHUCK E CHEESE'S

THESE DOCUMENTS ARE THE SOLE PROPERTY OF SHOWBIZ PIZZA TIME, INC. ANY COPYING OR USE OF THESE DOCUMENTS FOR ANY PURPOSE OTHER THAN CONSTRUCTION OF THIS PROJECT WITHOUT THE EXPRESS WRITTEN PERMISSION OF THE ARCHITECT AND SHOWBIZ PIZZA IS PROHIBITED.

CHUCK E. CHEESE'S PIZZA #3161 – ALBUQUERQUE
4418 WYOMING NE – ALBUQUERQUE, NEW MEXICO – 87111
SPRING VALLEY AMUSEMENT, INC.
5778 ARROWHEAD DRIVE • SUITE 108
VIRGINIA BEACH, VIRGINIA 23462

NOTES AND DETAILS

Date
04 AUGUST 1992

Revisions

Project Number
92-090

Sheet Number
A7
of 8

REV 440 DATE 6/14/93 BY ESP
CITY OF ALBUQUERQUE
This microimage is certified to be a complete and accurate copy of the original as it appears in the files of the CODE ADMINISTRATION DIVISION and was filmed in the normal course of business. The photographic processes used meet the Basic Microfilm Standards of the National Micrographics Association (NS115-1977).
Karen Aceves
CITY CLERK RECORDER
OFFICIAL SEAL NORBERTA SANCHEZ NOTARY PUBLIC STATE OF NEW MEXICO
My Commission Expires MAY 8, 1995
Norberta Sanchez

D 24 C 20 B 16 A 12

CITY OF ALBUQUERQUE

C D

GENERAL CONTRACTOR NOTES

1. Verify OWNER FURNISHED items with Project Manager prior to Construction. General Contractor to be responsible for unloading of Owner Provided items from Owner's trailer.
2. Verify all HEALTH DEPARTMENT REQUIREMENTS are met during remodel.
3. Project Manager will determine whether counters, fixtures and other assets will be kept or disposed of by contractor.
4. Field verify all measurements, dimensions, elevations and conditions prior to construction.
5. All dimensions are to take precedence over scale dimensions on plans, elevations, sections and details.
6. G.C. to hang menu board, employee plaques, and all signs with pan head screws. Neon to be installed by owner.
7. Not Used.
8. Sprinkler system to be lowered or raised to new ceiling height in all areas where needed. G. C. to use licensed fire sprinkler company. Company to provide owner with plan after completion.
9. Sprinkler company to supply five extra heads and wrench (the wrench to remain in sprinkler closet).
10. NOT USED
11. G. C. to remount air diffusers and return air grills after any work on ceiling.
12. All new full walls and half-walls must have vinyl base to match existing base.
13. All walls and ceilings of food areas must be smooth, easily cleanable and light in color.
14. Any exposed sheetrock edges to have J mold.
15. All trim must extend to end of walls, doors, etc. (trim to match existing).
16. Provide and install 1x4 red oak chair rail on all walls. Caulk top and bottom.
17. All oak to be installed with Robertson screws.
18. Re-carpet room no.'s: 102, 105, 112, 106, 113, 115, 116 & 117
19. Install OWNER PROVIDED drop safes and cash drawers, in new order counter.
20. Provide and install mirrors with full coverage mastic. Caulk mirror and wall joints.
21. Add traps to any drain worked on under Scope of Work.
22. Run drain line for Coke machine.
23. Run water line to coffeemaker, teamaker & coke machine in beverage area.
24. Run water line to tea maker in kitchen next to pick up window.
25. Use FRP behind beverage area, match existing. See detail.
26. Caulk back splash on beverage counter top, bottom and sides.
27. Provide and install aluminum corner guards on new beverage bar. See detail.
28. All salad bars, buffet-type food service and other self-serve food shall be shielded so as to intercept a direct line between the customer's mouth and the food being displayed, by the proper positioning of the sneeze guard. Verify with Health Department regulations.
29. G.C. to mount portion chart one foot (1') above make table whether hung from ceiling or mounted on make table.
30. Run line concealed in wall to valved termination at KNOCK - OUTS and Whac-A-Demon locations. Use 1" PVC schedule 40.
31. Provide and install in-line ball valves on all plumbing changes or additions.
32. G. C. to cut opening through wall for slim line beer cabinet. Ref Sheet A7. Beer box installation by General Contractor. Purchase and install stainless steel cover for unused dispenser opening on beer box and seal.
33. GENERAL CONTRACTOR IS TO PROVIDE ONE (1) SET OF ACCURATE AS-BUILT DRAWINGS TO OWNER. VERIFY REQUIREMENTS WITH OWNER.
34. Provide and install D.W.V. drain line run from salad pan to existing floor drain/sink. Provide 1-1/2" gap between salad drain and floor drain/sink. (See Note 62 also for GC note).
35. G.C. to mount guest check holder to bottom of portion chart.
36. Remove pass-thru shelf. Patch wall to match existing finish.
37. G.C. to install existing glass chiller behind order counter prior to sitting counter in place. Field verify chiller is on site. If no chiller is available, unbolt wheels of under counter refrigerator and install behind order counter prior to sitting counter in place. Legs to remain on unit.
38. All wood trim to be natural color.
39. All light bulbs will be re-installed each day.
40. Caulk all cracks and joints.
41. All outlet covers must be replaced each day.
42. All outer doors, new and existing, must be self-closing and tight fitting.
43. Relocate fire extinguishers where required.
44. Relocate fire alarm where needed. G.C. to use a licensed fire alarm company, if necessary.
45. Replace any broken or missing quarry tile and quarry base.
46. Put quarry tile base on back of self-serve beverage kitchen side. Match existing.
47. Remove dimmer boxes, patch walls where dimmers and switches are removed.
48. Reinstall two (2) 'KIDS APPRECIATE..." signs in kiddie area.
49. Carpet Space Station/Ball Crawl steps.
50. Lay carpet from front to back of building.
51. Provide and install 2 x 8 plex on ceiling tile over Hoop Shot. Screw to grid with six screws and spacers. Install plex parallel to Hoop Shot.
52. Hand six (6) Dock umbrellas randomly, not in pattern, in kiddie area where light does not shine on them.
53. Provide and install Marlite corner mold on all halfwall corners and 1/2" x 3" x 14" metal angle or 2" dia. pipe brace at all halfwall openings. Cover both sides of halfwall with Marlite 5407 Buff. DO NOT PAINT UNLESS OTHERWISE NOTED ON ELEVATIONS.
54. Rework air ducts where required.
55. G.C. to saw cut floor for floor receptacles, with a electric wet saw, the full depth of slab.
56. Remove existing men and women signs on restroom doors. Install new signs in same location on restroom doors.
57. Insulate all copper tubing which penetrates walls.
58. NOT USED
59. Put plastic down under any saw being used in store.
60. Aluminum beverage corner guards to be installed above base.
61. General Contractor to remove wall vinyl before painter textures and paints.
62. General Contractor to field cut salad bar top to fit existing salad pan/pans.
63. General Contractor to assemble and install owner provided park benches.
64. General Contractor to assemble table tops and bases and set booths and tables in place.
65. General Contractor to provide and install aluminum track, #A3752-1860-8786, with rubber divider T# 7 1/4 leg 1776-0125 where carpet meets vinyl and/or quarry.
66. General Contractor to require carpet layer to use seam sealer on carpet seams.
67. General Contractor to install diaper changing shelf provided by the Owner in the women's restroom.
68. General Contractor to install transition strips at all flooring changes.

RESPONSIBILITY CHART

DESCRIPTION	PROVIDED BY	INSTALLED BY
INTERIOR AWNINGS	OWNER	G.C.
WALL PORTRAITS	OWNER	G.C.
MURALS	OWNER	G.C.
VINYL CHECKS 22 LINEAR FEET	OWNER	G.C.
UMBRELLAS	OWNER	G.C.
PLANTS	OWNER	G.C.
CURTAINS	OWNER	G.C.
SPEAKER CLOTH	OWNER	G.C.
EXTERIOR SIGNAGE	OWNER	OTHER
INTERIOR NEON	OWNER	OTHER
BASE NEON PACKAGE(S)	OWNER	G.C.
MENU BOARD	OWNER	G.C.
MENU SLATS	OWNER	OTHER
SIGNAGE	OWNER	
COIN CHANGER	OWNER	G.C.
BATTER UP	OWNER	G.C.
MEN/WOMEN	OWNER	G.C.
OCCUPANCY	OWNER	G.C.
CONST. POSTERS	OWNER	OWNER
ROLLER BOWLER SIGN	OWNER	G.C.
SKEEBALLS SIGN	OWNER	OWNER
MIRRORS	G.C.	G.C.
GLASS SHELVES	G.C.	G.C.
SHELVES	G.C.	G.C.
WINDOWS	G.C.	G.C.
STAIR NOSING	G.C.	G.C.
WATCH YOUR STEP SIGN	OWNER	G.C.
OPERATIONS SIGN	OWNER	G.C.
RESTROOMS SIGNS	OWNER	G.C.
ELECTRICAL MATERIALS		G.C.
HANGING LIGHTS	OWNER	G.C.
LIGHT INSERTS	OWNER	G.C.
LAMPS	G.C.	G.C.
INCANDESCENT FIXTURES	G.C.	G.C.
FLUORESCENT FIXTURES	G.C.	G.C.
FLOORING & OTHER MATERIALS		G.C.
CARPET _____ SQUARE FEET	OWNER	G.C.
TILE	G.C.	G.C.
VINYL CROSSWALK	OWNER	G.C.
CABINET/COUNTERS	OWNER	G.C.
GIFT CADDY	OWNER	G.C.
DROP BOXES	OWNER	G.C.
SALAD BAR/SNEEZE G	OWNER	G.C.
CONDIMENT BAR	OWNER	G.C.
CHROME TUBES	OWNER	G.C.
THANK YOU BOXES	OWNER	G.C.
HOSTESS STAND	OWNER	G.C.
COAT RACKS	OWNER	G.C.
BOOTH INSERTS	OWNER	G.C.
STAINLESS BEVERAGE CENTER	OWNER	G.C.
BEER SYSTEM	OWNER	G.C.
DRAIN PAN	OWNER	G.C.
COKE DISPENSER	OWNER	G.C.
ICE MACHINE	OWNER	G.C.
REFRIGERATOR	OWNER	G.C.
COFFEE/TEA DISPENSER	OWNER	G.C.
SALAD PAN	OWNER	G.C.
CUP DISPENSER	OWNER	G.C.
LID DISPENSER	OWNER	G.C.
TRASH LINERS	OWNER	G.C.
SECURITY SYSTEM	EXISTING	G.C.
BOOTHS	OWNER	G.C.
BENCHES (INTERIOR)	OWNER	G.C.
BENCHES (EXTERIOR)	OWNER\G.C.	G.C.
TABLES	OWNER	G.C.
BASES	OWNER	G.C.
UPHOLSTERY	G.C.	G.C.
EXTERIOR AWNINGS	OWNER	G.C.
DOOR HARDWARE	G.C.	G.C.
INTERIOR DOORS	G.C.	G.C.
FRONT DOORS	G.C.	G.C.
VINYL BASE	G.C.	G.C.
QUARRY TILE	G.C.	G.C.
QUARRY BASE	G.C.	G.C.
MARLITE	G.C.	G.C.
OAK TRIM	G.C.	G.C.
BABY CHANGING AREA	OWNER	G.C.
PIZZA PAN DISPLAY SET	OWNER	G.C.

GENERAL PAINTING NOTES

1. Provide plastic to cover items not being painted.
2. Spray ceiling mounted and receded speakers with hi-gloss white enamel.
3. Hand paint ceiling projector, light bars and vents. DO NOT paint instruction plate on back of the projector.
4. Remove all ceiling clips prior to painting ceiling.
5. Paint ceiling tile and grid P-11 in all public areas.
6. Paint ceiling over stage P-11.
7. Clean and paint all ceiling diffusers in public areas, and reinstall.
8. All items taped, covered up or removed, must be returned to operating condition each day.
9. Use quick drying mud for joints and texture.
10. All trim to be sanded and sealed all four sides.
11. Remove all door hardware, clean and reinstall after painting doors. Do not paint gasket on door windows.
12. Paint and seal front doors before installation.
13. All cracks to be filled before painting.
14. Paint sides of ball crow steps P-2.
15. Spray coin changers with White Epoxy Glidetheane - 4550. All painted games or coin changer surfaces to have Penatrol added to paint.
16. Spray brown table bases flat black, if needed.

EXTERIOR PAINTING NOTES

1. Paint exterior of building except for brick and brick trim as specified on plans. Renail any loose boards on parapet before painting.
2. Paint any exterior electrical panels, conduits and gas piping P-6.
3. Paint exterior awing hangers, if needed.
4. Paint exterior wall hydrant box P-6, only if it is not brass.
5. Paint "NOW APPEARING" boxes P-12, making sure the "A" and NOW APPEARING is painted out.
6. Drop cloths are to be used wherever painting is being done.
7. There are to be NO ALTERNATES to paint schedule.

PAINT SCHEDULE

KEY	NAME	BASE	FORMULA
P-1	GLIDDEN INTERMEZZO - Interior Walls Semi-gloss	3718	YOX-6, LY-7, BLK-2
P-1A	GLIDDEN INTERMEZZO - Semi-gloss	4618	YOX-6, LY-7, BLK-2
P-2	GLIDDEN 80-18 Interior Blue Semi-gloss	4699	TBL-8P, V10-2P, BLK-24, W-32.
P-3	GLIDDEN GREEN - Restroom Semi-gloss	4680	NF-1P44, TGR-6P50, TBL-8.
P-4	GLIDDEN SAFETY RED - Front Door Exterior Checkerboards High-gloss	4520	
P-5	GLIDDEN IMPERIAL BLUE - Exterior Checkerboards High-gloss	4564	
P-6	GLIDDEN SWEDISH SNOW ENAMEL Exterior Walls - Semi-gloss	3918	OXR-1
P-7	GLIDDEN POLYURETHANE - Satin Finish - Front Door Satin Finish - Interior		
P-8	LACQUER SAND AND SEAL - Natural Finish Semi-gloss		
P-9	GLIDDEN GREEN - Exterior Checkerboards High-gloss	4580	YEG-5P-16 TGR-2P-48 NT-12
P-10	GLIDDEN GOLD - Exterior Checkerboards High-gloss	4580	RO-1P-36 YL-9P-24
P-11	GLIDDEN ACOUSTIC WHITE - Ceiling Tile - Flat White	5070	RO-1, NT-3
P-12	GLIDDEN GREEN - Now Appearing Boxes High-gloss	4580	LY-3P50, TGR-5P26, BLK-2P58

TOKEN CHANGE MACHINE - GLIDDEN WHITE EPOXY GLIDETHANE - 4550.

DEMOLITION NOTES

1. Prior to demolition, contractor will cover and protect all chairs, tables, fixtures, ALL GAMES, and rides.
2. Prior to sawcutting floor (wet saw only). Contractor will verify game layout.
3. Contractor will provide a minimum 30 CU dumpster at location during demolition.
4. Demolition schedule to be approved by Project Manager prior to start.
5. Patch and refinish walls and floors at all "demoed" wall locations.
6. Install new grid and ceiling tile when walls have been removed.
7. Remove power poles.
8. Remove all panels over the dimmers, show controls, etc. and patch wall. Finish to match existing.
9. Remove monitor shelves, and store monitors at location.
10. All remodeled walls, ceilings and floors of food preparation and storage areas must be smooth, non-absorbent, easy to clean and light colored.
11. Patch holes on wall where shelves are removed.
12. Relocate Everpure filter system to new COKE water system, if needed.
13. Relocate fire extinguishers where necessory.
14. Floor stone floor where needed.
15. Remove clips on ceiling before ceiling is painted.
16. All existing floor drains, floor sinks and cleanouts to remain unless otherwise noted.
17. Remove any existing wainscoting, paneling, carpet, sound board & trim on walls. Repair and refinish walls.
18. All plumbing in remodeled areas not being used should be disconnected, capped and leveled w/ floor. New finish to match existing.

TABLE SCHEDULE

LOCATION	SIZE	No.	REMARKS
SHOWROOM	42" x 30"	___	EXISTING
	60" x 30"	___	EXISTING
	30" x 48"	___	NEW WITH BASE
SKILLS	48" x 30"	___	NEW WITH BASE
KIDDIE	48" x 30"	___	NEW WITH BASE
	40" x 40"	___	NEW WITH BASE

BOOTHS SCHEDULE

LOCATION	SIZE	No.	REMARKS
SHOWROOM	60" SINGLE	___	EXISTING
	60" DOUBLE	___	EXISTING
	48" SINGLE	___	NEW
	48" DOUBLE	___	NEW
SKILLS	48" SINGLE	___	NEW
	48" DOUBLE	___	NEW
KIDDIE	48" SINGLE	___	NEW
	48" DOUBLE	___	NEW
	3/4 BOOTH	___	NEW

___	CHAIRS	___	NEW BASES
		___	NEW 1 LEG BASES

DOOR HARDWARE SCHEDULE

HARDWARE SET #1 — DOOR D-1, D-1A
3'-0" X 7'-0 X 1-3/4" (TYPE "A").
18 GA. HOLLOW METAL DOOR & 16 GA. FRAME

LCN	CLOSER 4040 SNB, US3 FINISH
HAGER	BUTTS (3) PER DOOR, BB-1279 4.5" X 4.5" NRP, US3
HAGER	FLUSH BOLTS #282D ON INSIDE, US3 FINISH
SCHLAGE	DEADBOLT (1) #B-460P W/ INSIDE THUMB, US3
HAGER	KICK PLATES (2) 8" X 34" INSIDE & OUTSIDE - US3
HAGER	PUSH PLATES (2) #305 3.5" X 15" US3
HAGER	PULL PLATES (2) #400 3.5" X 15" US3
BALDWIN	SILENCERS (6) #4035
VON DUPRIN	TOUCH BAR 99 SERIES 9975-F US3 FINISH
NAT. GUARD	THRESHOLD #4286EV ALUMINUM, GOLD ANODIZED
NAT. GUARD	ASTRAGAL #140PB 2-7' ALUMINUM, GOLD ANODIZED
NAT. GUARD	WEATHERSTRIP #160AV 20' ALUMINUM, GOLD ANODIZED
HAGER	FLOOR STOP #252F WITH RISER AS REQUIRED, US3

NTE: DOOR D-1A TO BE WOOD - FINISH TO BE P-1

HARDWARE SET #2 — DOORS D-2 & D-3
3'-0" X 7'-0" X 1-3/4" (TYPE "B")
W/10" X 10" CLEAR GLASS INSERT.
SOLID CORE DOOR W/HOLLOW METAL FRAME.

STANLEY	BUTTS BVV179 26D 4.5" X 4.5" (TWO PAIR)
CIPCO	PUSH PLATE 550K-630
CIPCO	PULL PLATE 550K X 43-630
LCN	CLOSER 1560
CIPCO	KICK PLATE 5153 30" X 34"
IVES	STOP (1) 436 B26D

HARDWARE SET #3 — DOOR D-4
3'-0" X 7'-0" X 1-3/4" (TYPE "C")
SOLID CORE DOOR W/HOLLOW METAL FRAME.

HAGER	BUTTS (1-1/2 PAIR) #BB 1191 4.5" X 4.5"
SCHLAGE	LOCKSET (1) A53PD US3 ENTRY - KEY ONE SIDE US32D
IVES	STOP (1) 436 B26D

HARDWARE SET #4 — DOOR D-5
3'-0" X 7'-0" X 1-3/4" (TYPE "C")
HOLLOW METAL DOOR & FRAME.

SARGENT	PANIC EXIT DEVICE 9810
STANLEY	BUTTS (1-1/2 PAIR) 4-1/2" X 4-1/2" X NRP. FBB179 26D.
PEMKO	THRESHOLD 178A SADDLE OR EQUAL.

HARDWARE SET #5 — DOOR D-7 & D-8
3'-0" X 7'-0" X 1-3/4" (TYPE "D")
SOLID CORE WOOD RAISED PANEL DOOR

LCN	CLOSER 4040 SNB, US3 FINISH
HAGER	BUTTS (3) PER DOOR, BB-1279 4.5" X4.5" NRP, US3
HAGER	PUSH PLATES (2) #30S 4" X 16" US3
HAGER	KICK PLATES (2) 8" X 34" INSIDE & OUTSIDE - US3
BALDWIN	PULL (2) #32G 4" X 16" US3
B. BRASS	SILENCERS (6) #4035
	WALL STOP #W9, US3

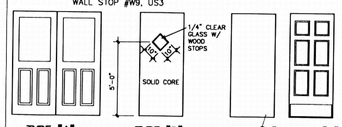

D-G = RELOCATE EXISTING DOOR, FRAME & HARDWARE

ELECTRICAL NOTES

1. Remove lights in existing sneeze guard.
2. Replace any missing baffles.
3. Remove outlets, conduit and switches from any wall to be demolished.
4. Make certain all outlets work.
5. Install six (6) or seven (7) ceiling outlets for neon transformers. Verify on Power Plan. Neon installation by Owner.
6. Remove all dimmers and light switches except in showroom.
7. Relocate all emergency lights, security equipment and exit lights if necessary.
8. All light bulbs will be reinstalled each day.
9. All outlet covers must be replaced each day.
10. Remove power poles.
11. Relocate thermostats if and where necessary.
12. Reinstall all smoke detectors.
13. Label all panel breakers.
14. Shield all lights in food handling areas and provide 50 foot candles in light on all work surfaces.
15. On FIRST night check emergency and exit lights.
16. Check security system.
17. Paint all rim on fixtures.
18. Repair or replace all exit lights, if necessary.
19. All receptacles and plates to be ivory ❹ Buff Marlite & Brown ❹ Oak Marlite.
20. Relocate security pad if necessary. Verify with Project Manager.
21. Check outdoor lighting and sign override to make sure they are working.
22. Install owner provided inserts in all incandescents during re-lamping.
23. Replace any existing broken outlet covers.
24. Outlet on front of stage to be brown.
25. Provide and install two four foot (4') fluorescent tubes for sneeze guard. Install prior to hanging sneeze guard.
26. Provide and install two two-foot (2') fluorescent tubes for gift counter. Refer to lighting schedule.
27. Registers and printer require an isolated grounded receptacle on dedicated circuit.
28. Showroom hanging lights bottom of globe 5' 0" AFF.
29. Run flex in chrome tube through top of sneeze guard then to sneeze guard light.
30. Remove corridor fluorescents. Replace with incandescents. Refer E2.
31. Re-install contacts on all exterior doors after any work on those doors.
32. Verify that ceiling speakers in remodeled areas are in proper working after ceiling & electrical work is complete.
33. Verify that the alarm system is in proper working order after ceiling & electrical work is complete.
34. Provide and install outlet above ceiling for all neon. Run all necessary wiring.

LIGHT BULB SCHEDULE

FIXTURE	LOCATION	No.	VOLTS	LAMPS
B, C & P	SKILLS/KIDDIE/ CORRIDOR.	___	120 V.	1: 150 W. A-21 WHITE.
B & C	SHOWROOM.	___	120 V.	1: 100 W. A-21, SYLVANIA SOFT PINK.
K	SHOWROOM.	___	120 V.	1: 60 W. A-19, SYLVANIA SOFT PINK.
L & N	CORRIDOR	___	120 V.	1: 90 W. PAR-38 FLOOD.

LIGHTING SCHEDULE

KEY	DESCRIPTION	No.	NOTES	MFG.
A	RECESSED INCANDESCENT TO BE RELOCATED	___		EXISTING
B	FIXTURE TYPE "A" MOVED TO NEW LOCATION	___	WITH OMEGA YPS-6E REFLECTOR INSERT	EXISTING VERIFY
C	FIXTURE TYPE "A" TO REMAIN AT LOCATION	___	WITH OMEGA YPS-6E REFLECTOR INSERT	EXISTING TO TO REMAIN
D	2 LB 240B FIXTURE WITH F40 T12CW PROVIDED BY ELECTRICAL CONTRACTOR	2	BEVERAGE	LITHONIA
E	C 140 FIXTURE SPX35 F40, SLH ENERGY SAVING BALLAST SUPER LOW HEAT WITH TUBE GUARD PROVIDED BY ELECTRICAL CONTRACTOR	2	SNEEZE GUARD USE SYLVANIA F40 GRO-LUX LAMP (F40GRO)	LITHONIA
F	C 120 FIXTURE SPX35 F20, SLH ENERGY SAVING BALLAST SUPER LOW HEAT WITH TUBE GUARD PROVIDED BY ELECTRICAL CONTRACTOR	2	SNEEZE GUARD USE SYLVANIA F20 GRO-LUX LAMP (F20T12GRO)	LITHONIA
H	S 130 FIXTURE WITH F30 T12 CW PROVIDED BY ELECTRICAL CONTRACTOR	2	GIFT COUNTER (1 PER CASE)	LITHONIA
K	HANGING LIGHT 3074-06 PB WHT. 17" CHROME PROVIDED BY OWNER	___	SHOWROOM	PARK ROW LIGHTING
L	150 WR-40 HOUSING 1202 TRIM 1222 PROVIDED BY ELECTRICAL CONTRACTOR	___	EYEBALL	LIGHTOLIER
M	RECESSED EYEBALL FIXTURE TO BE RELOCATED	___	WITH OMEGA YPS-6E REFLECTOR INSERT	EXISTING
N	FIXTURE TYPE "M" MOVED TO NEW LOCATION	___	WITH OMEGA YPS-6E REFLECTOR INSERT	EXISTING
P	RECESSED INCANDESCENT AT NEW LOCATION PROVIDED BY ELECTRICAL CONTRACTOR	___	WITH OMEGA YPS-6E REFLECTOR INSERT	NEW - MATCH FIXTURE TYPE "A"

RELAMP ALL LIGHTS UNDER SCOPE OF WORK. SHOWROOM WITH PINK BULBS AND ALL OTHER AREAS WITH WHITE BULBS. SEE LIGHT BULB SCHEDULE. ELECTRICIAN TO INSTALL OWNER PROVIDED OMEGA INSERTS IN ALL INCANDESCENTS DURING RELAMPING.

ALBUQUERQUE CODE ADMIN. OCT 06 1992 U.S.C. PLAN CHECK SECTION

C. C. KOEHLER, CONSULTING ARCHITECT, A.I.A.

B&W BURSON AND WILLIAMS ARCHITECTS INC.
8501 Black Street • Dallas, Texas 75204 • 214/371-0774

REGISTERED ARCHITECT — STATE OF NEW MEXICO — C. C. KOEHLER — 933 — 10/31/93

CHUCK E. CHEESE'S PIZZA

THESE DOCUMENTS ARE THE SOLE PROPERTY OF SHOWBIZ PIZZA TIME, INC. ANY COPYING OR USE OF THESE DOCUMENTS FOR ANY PURPOSE OTHER THAN CONSTRUCTION OF THIS PROJECT WITHOUT THE EXPRESS WRITTEN PERMISSION OF THE ARCHITECT AND SHOWBIZ PIZZA IS PROHIBITED.

CHUCK E. CHEESE'S PIZZA #3161 - ALBUQUERQUE
4418 WYOMING NE - ALBUQUERQUE, NEW MEXICO - 87111

SPRING VALLEY AMUSEMENT, INC.
5776 ARROWHEAD DRIVE - SUITE 108
VIRGINIA BEACH, VIRGINIA 23462

NOTES AND SCHEDULES

Date: 04 AUGUST 1992

Revisions

Project Number: 92-090

Sheet Number: A8 of 8

RP 440 DATE 6/14/93 OP ESP

CITY OF ALBUQUERQUE

This microimage is certified to be a complete and accurate copy of the original as it appears in the files of the CITY ADMINISTRATION DIVISION and was filmed in the normal course of business. The photographic processes used meet the Basic Microfilm Standards of the National Micrographics Association (MS115-1977).

CITY CLERK RECORDER

OFFICIAL SEAL NORIETTA SANCHEZ NOTARY PUBLIC STATE OF NEW MEXICO My Commission Expires MAY 5, 1995

D 24 C 20 B 16 A 12 | CITY OF ALBUQUERQUE C D

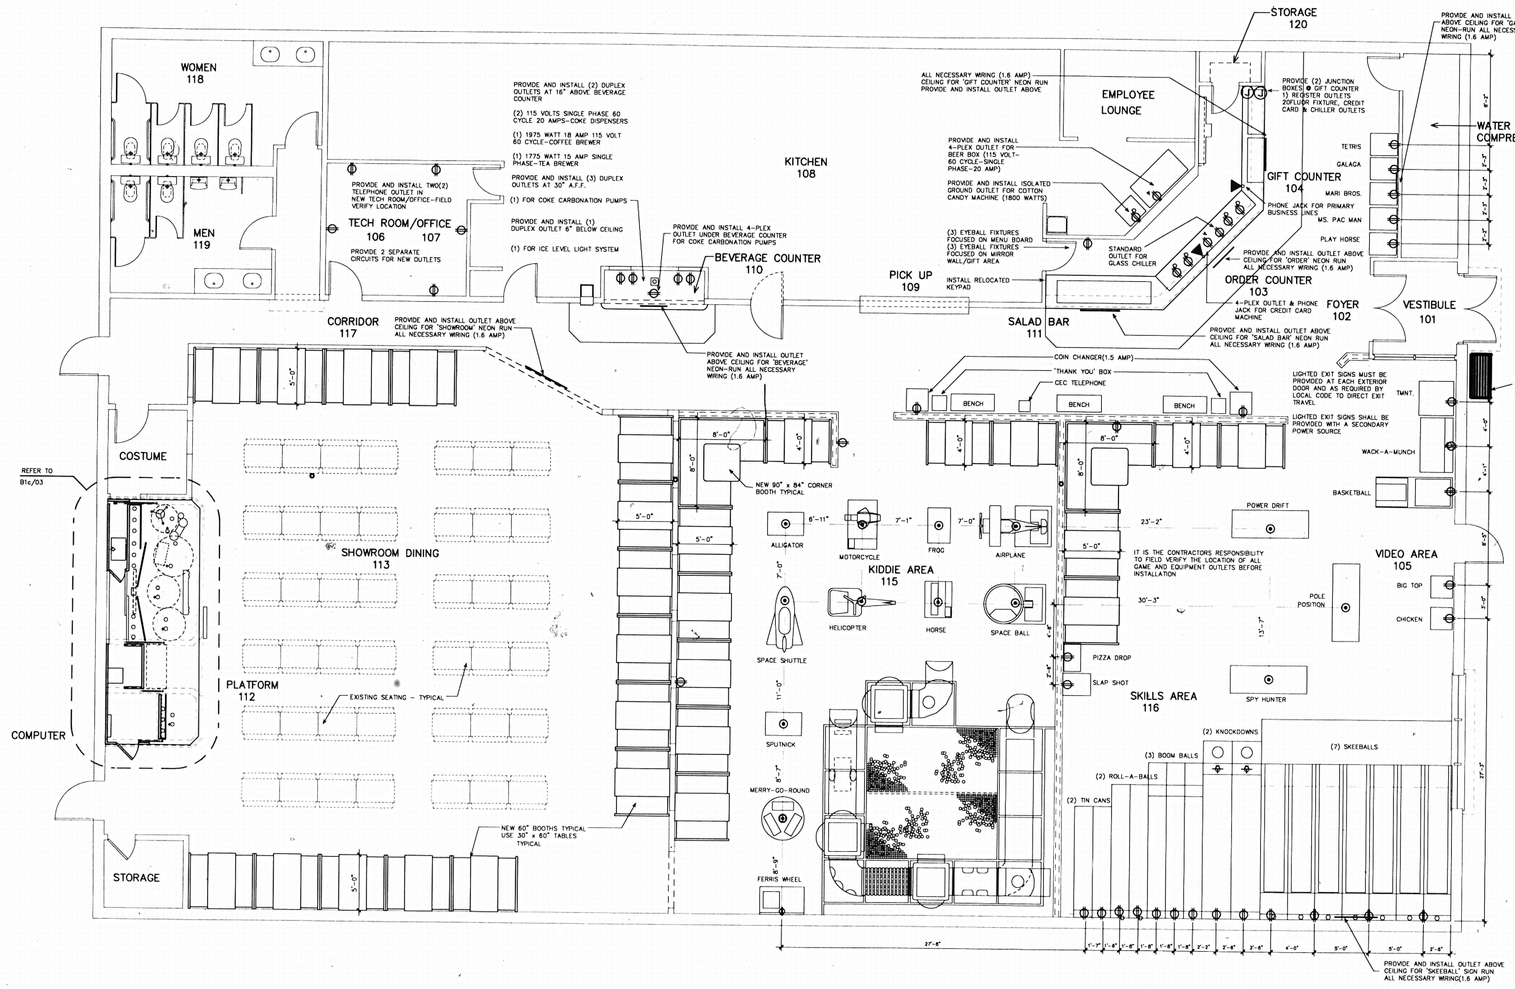

01 ELECTRICAL, GAMES AND SEATING PLAN

SCALE: 3/16" = 1'-0"

NOTE:

1. REWORK REGISTER OUTLETS:
   (4) ISOLATED OUTLETS AT ORDER COUNTER GROUNDED DEDICATED CIRCUIT.
   (1) STANDARD OUTLET FOR GLASS CHILLER. 7 AMPS SINGLE PHASE AT ORDER COUNTER.
   (1) 4-PLEX OUTLET & TELEPHONE JACK FOR CREDIT CARD MACHINE
2. REMOVE ALL BELOW CEILING LIGHTS
3. INSTALL EYEBALL SPOTS AIMED ON AWNINGS REFER SHEET E-2
4. REPLACE ANY EXISTING BROKEN OUTLET COVERS
5. REMOVE CORRIDOR FLUORESCENTS REPLACE WITH INCANDESCENTS REFER SHEET E-2
6. RE-INSTALL CONTACTS ON ALL DOORS AFTER ANY WORK ON DOORS
7. VERIFY THAT CONTACTS ARE IN WORKING ORDER
8. VERIFY THAT CEILING SPEAKERS IN REMODELED AREAS ARE IN PROPER WORKING ORDER AFTER CEILING/ELECTRICAL WORK IS COMPLETE
9. VERIFY THAT THE ALARM SYSTEM IS IN PROPER WORKING ORDER AFTER CEILING/ ELECTRICAL WORK IS DONE
10. PROVIDE AND INSTALL SNEEZE GUARD LAMP PRIOR TO HANGING SNEEZE GUARD. RUN FLEX IN CHROME TUBE THRU TOP OF SNEEZE GUARD LIGHT.
11. RELOCATE ALL EXISTING ELECTRICAL SWITCHES AND OUTLETS ON WALLS THAT MOVE.
12. ALL ELECTRICAL WORK SHALL CONFORM TO LOCAL CODE REQUIREMENTS
13. ALL NEON SIGNS TO BE ON DEDICATED CIRCUITS

POSTERS/PORTRAITS SCHEDULE:

PARODY POSTERS (9)
GENERAL CONTRACTOR IS TO INSTALL PARODY POSTERS PROVIDED BY OWNER
1 PP - CHUCK TO THE FUTURE
2 PP - BAT MUNCH
3 PP - BEAGLE JUICE
4 PP - GONE WITH THE WING
5 PP - INDIANA JOWLS
6 PP - WIZARD OF CHEESE
7 PP - JAWS
8 PP - CLOSE ENCOUNTERS OF THE BIRD KIND
9 PP - CROCODILE CHUCK E.

WALL PORTRAITS (5)
GENERAL CONTRACTOR IS TO INSTALL WALL PORTRAITS PROVIDED BY OWNER
1 WP - CHUCK E. CHEESE
2 WP - MR. MUNCH
3 WP - JASPER T. JOWLS
4 WP - HELEN HENNY
5 WP - PASQUALLY

GENERAL CONTRACTOR IS TO PROVIDE AND INSTALL (2) RED OAK FRAMES - REFER TO A7/01

GENERAL CONTRACTOR IS TO INSTALL WALL MURALS PROVIDED BY OWNER AS INDICATED ON DRAWING

LEGEND

- NEW DUPLEX OUTLET
- NEW DEDICATED OUTLET
- NEW 4-PLEX OUTLET
- EXISTING OUTLET (VERIFY)
- NEW FLOOR OUTLET

NOTE: IT IS THE CONTRACTORS RESPONSIBILITY TO FIELD VERIFY THE LOCATION AND OPERATION OF ALL EXISTING ELECTRICAL OUTLETS - REUSE IF POSSIBLE

C. C. KOEHLER, CONSULTING ARCHITECT, A.I.A.

B&W BURSON AND WILLIAMS ARCHITECTS INC.
8501 Flinn Street • Dallas, Texas 75206 • 214/691-4774

CLAYTON C. KOEHLER 5157 REGISTERED ARCHITECT STATE OF NEW MEXICO

CHUCK E. CHEESE'S

THESE DOCUMENTS ARE THE SOLE PROPERTY OF SHOWBIZ PIZZA TIME, INC. ANY COPYING OR USE OF THESE DOCUMENTS FOR ANY PURPOSE OTHER THAN CONSTRUCTION OF THIS PROJECT WITHOUT THE EXPRESS WRITTEN PERMISSION OF THE ARCHITECT AND SHOWBIZ PIZZA IS PROHIBITED.

CHUCK E. CHEESE'S PIZZA #3161 - ALBUQUERQUE

4418 WYOMING NE - ALBUQUERQUE, NEW MEXICO - 87111

SPRING VALLEY AMUSEMENT, INC.
5776 ARROWHEAD DRIVE - SUITE 108
VIRGINIA BEACH, VIRGINIA 23462

ELECTRICAL, GAMES AND SEATING PLAN

Date
04 AUGUST 1992

Revisions

Project Number
92-090

Sheet Number
E1
of 2

BLF 440 DATE 6/4/93 CP ESP

CITY OF ALBUQUERQUE

This microimage is certified to be a complete and accurate copy of the original as it appears in the files of the CODE ADMINISTRATION DIVISION and was filmed in the normal course of business. The photographic processes used meet the Basic Microfilm Standards of the National Micrographics Association (NS115-1977).

Karen Aimes
CITY CLERK RECORDER

OFFICIAL SEAL NORBERTA SANCHEZ NOTARY PUBLIC STATE OF NEW MEXICO
My Commission Expires MAY 8, 1995
Norberta Sanchez

D 24 C 20 B 16 A 12

CITY OF ALBUQUERQUE

C D

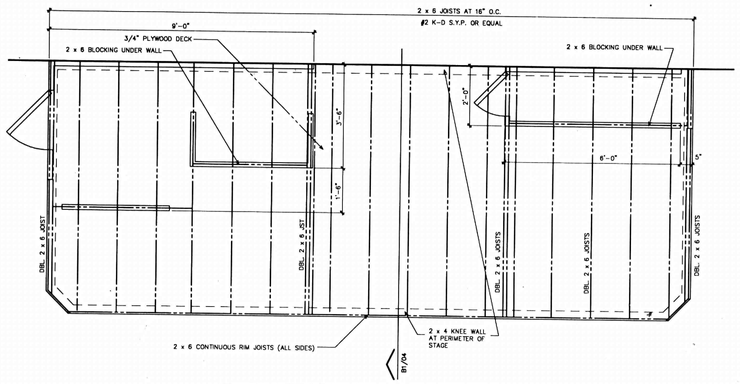

02 PLATFORM FRAMING PLAN
SCALE: 1/2" = 1'-0"

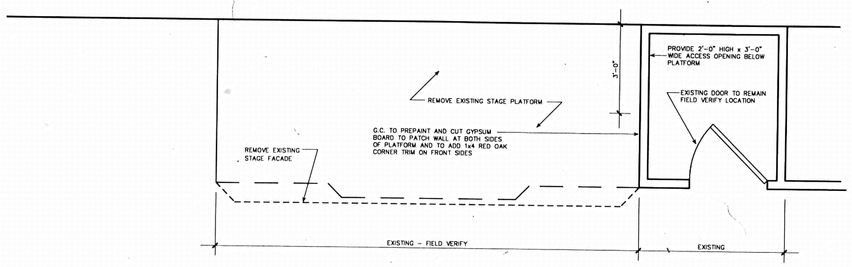

01 DEMOLITION PLAN EXISTING PLATFORM
SCALE: 1/2" = 1'-0"

21. Wood joist, floor trusses and roof trusses spaced 24" o.c. with ½" plywood with exterior glue applied at right angles to top of joist or truss web 8d nails. The plywood thickness shall not be less than ½" nor less than required by Chapter 25.	21.1.1	Base layer ⅝" Type X gypsum wallboard applied at right angles to joist or truss 24" o.c. with 1¼" Type S or Type W drywall screws 24" o.c. Face layer ⅝" Type X gypsum wallboard or veneer base applied at right angles to joist or truss through base layer with 1¾" Type S or Type W drywall screws 12" o.c. at joists and intermediate joist or truss. Face layer joints offset 24" from base layer joints, 1½" Type G drywall screws placed 2" back on either side of face layer end joints, 12" o.c.	Varies	1hr

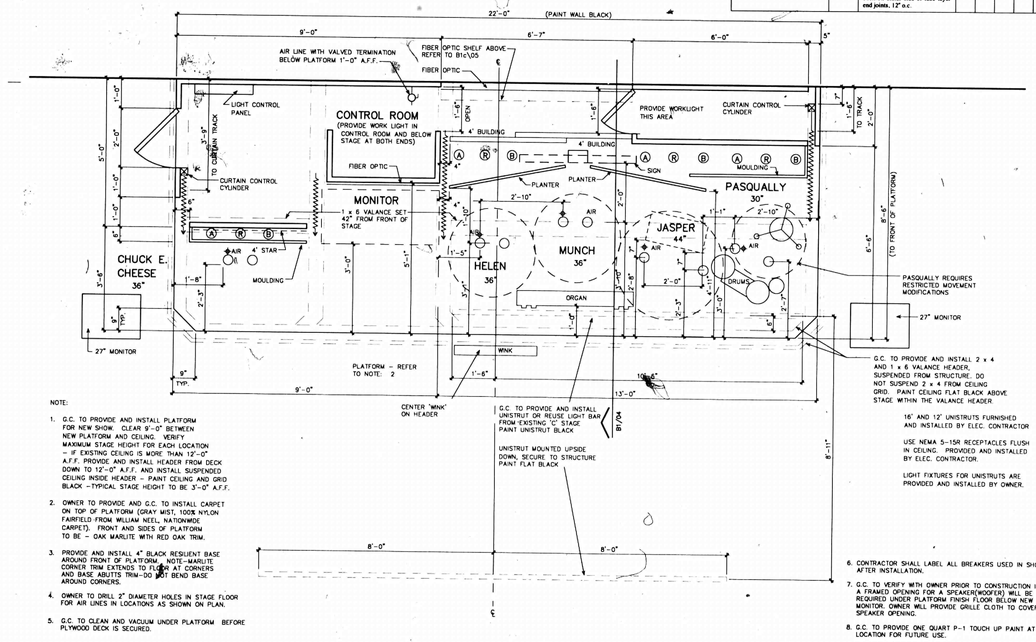

NOTE:

1. G.C. TO PROVIDE AND INSTALL PLATFORM FOR NEW SHOW. CLEAR 9'-0" BETWEEN NEW PLATFORM AND CEILING. VERIFY MAXIMUM STAGE HEIGHT FOR EACH LOCATION - IF EXISTING CEILING IS MORE THAN 12'-0" A.F.F. PROVIDE AND INSTALL HEADER FROM DECK DOWN TO 12'-0" A.F.F. AND INSTALL SUSPENDED CEILING INSIDE HEADER - PAINT CEILING AND GRID BLACK - TYPICAL STAGE HEIGHT TO BE 3'-0" A.F.F.
2. OWNER TO PROVIDE AND G.C. TO INSTALL CARPET ON TOP OF PLATFORM (GRAY MIST, 100% NYLON FAIRFIELD FROM WILLIAM NEEL, NATIONWIDE CARPET). FRONT AND SIDES OF PLATFORM TO BE - OAK MARLITE WITH RED OAK TRIM.
3. PROVIDE AND INSTALL 4" BLACK RESILIENT BASE AROUND FRONT OF PLATFORM. NOTE-MARLITE CORNER TRIM EXTENDS TO FLOOR AT CORNERS AND BASE ABUTTS TRIM-DO NOT BEND BASE AROUND CORNERS.
4. OWNER TO DRILL 2" DIAMETER HOLES IN STAGE FLOOR FOR AIR LINES IN LOCATIONS AS SHOWN ON PLAN.
5. G.C. TO CLEAN AND VACUUM UNDER PLATFORM BEFORE PLYWOOD DECK IS SECURED.
6. CONTRACTOR SHALL LABEL ALL BREAKERS USED IN SHOW AFTER INSTALLATION.
7. G.C. TO VERIFY WITH OWNER PRIOR TO CONSTRUCTION IF A FRAMED OPENING FOR A SPEAKER(WOOFER) WILL BE REQUIRED UNDER PLATFORM FINISH FLOOR BELOW NEW MONITOR. OWNER WILL PROVIDE GRILLE CLOTH TO COVER SPEAKER OPENING.
8. G.C. TO PROVIDE ONE QUART P-1 TOUCH UP PAINT AT LOCATION FOR FUTURE USE.

03 SHOW PLAN (22'-0" 2 STAGE)
SCALE: 1/2" = 1'-0"

PAINT SCHEDULE

KEY	NAME	BASE	FORMULA
P-1	GLIDDEN INTERMEZZO - TOUCH UP SEMI-GLOSS	3718	YOX-6, LY-7, BLK-2

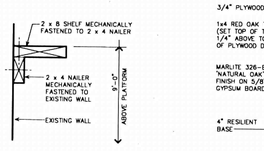

05 FIBER OPTIC SHELF
SCALE: 1 1/2" = 1'-0"

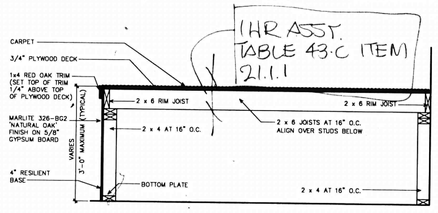

1HR ASST.
TABLE 43.C ITEM
21.1.1

04 PLATFORM SECTION
SCALE: 3/4" = 1'-0"

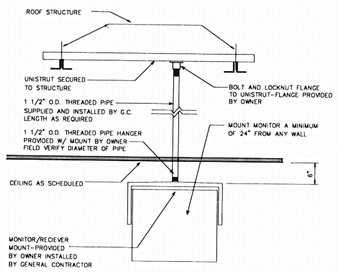

07 MONITOR MOUNTING
SCALE: 3/4" = 1'-0"

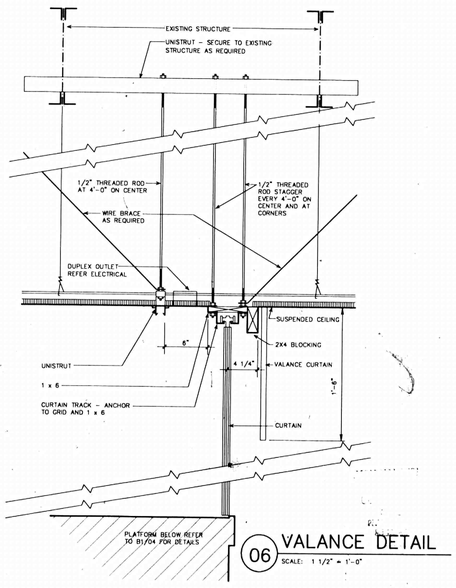

06 VALANCE DETAIL
SCALE: 1 1/2" = 1'-0"

C. C. KOEHLER, CONSULTING ARCHITECT, A.I.A.

BURBSW AND WILLIAMS ARCHITECTS INC.
3838 Blake Street • Dallas, Texas 75204 • 824/371-0771

STATE OF NEW MEXICO — CLEMENTS C. KOEHLER — 6857 — REGISTERED ARCHITECT

CHUCK E. CHEESE'S

THESE DOCUMENTS ARE THE SOLE PROPERTY OF SHOWBIZ PIZZA TIME, INC. ANY COPYING OR USE OF THESE DOCUMENTS FOR ANY PURPOSE OTHER THAN CONSTRUCTION OF THIS PROJECT WITHOUT THE EXPRESS WRITTEN PERMISSION OF THE ARCHITECT AND SHOWBIZ PIZZA IS PROHIBITED.

CHUCK E. CHEESE'S PIZZA #3161 - ALBUQUERQUE
4418 WYOMING NE - ALBUQUERQUE, NEW MEXICO - 87111
SPRING VALLEY AMUSEMENT, INC.
5757 WARNER AVENUE • SUITE 108
VIRGINIA BEACH, VIRGINIA 23462

SHOW PLANS - 22'-0" (2 BUILDINGS) ROLL OUT

Date
04 AUGUST 1992

Revisions

Project Number
92-090

Sheet Number
B1c
of 1

4418 Wyoming Blvd. NE

DESCRIPTION	DATE	BY
Permit	MAR 5 1993	JK

DRAWN BY — CHECKED BY — APPROVED BY — DATE — DUPLICATE CARDS — DATE RECEIVED BY

REF 1410 DATE 6/14/93 OP ESP
CITY OF ALBUQUERQUE
This microimage is certified to be a complete and accurate copy of the original as it appears in the files of the CODE ADMINISTRATION DIVISION and was filmed in the normal course of business. The photographic processes used meet the Basic Microfilm Standards of the National Micrographics Association (NS115-1977).
Karen Reeves
CITY CLERK RECORDER
OFFICIAL SEAL NORBERTA SANCHEZ NOTARY PUBLIC STATE OF NEW MEXICO
My Commission Expires MAY 8, 1995
Norberta Sanchez

D 24 C 20 B 16 A 12

CITY OF ALBUQUERQUE

C D

BUILDING & SAFETY PLANS 3 of 5

ADD: 4418 WYOMING BLVD. N.E.

DES: REMODEL

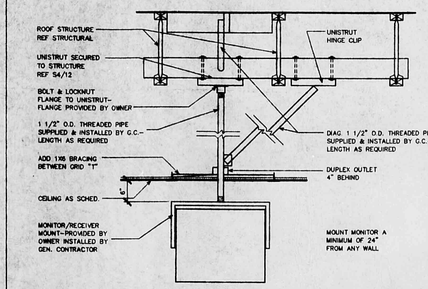

02 MONITOR MOUNT DETAIL

SCALE: 3/4" = 1'-0"

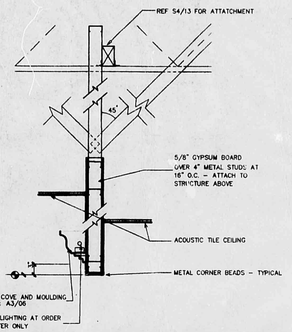

03 HEADER DETAIL AT ORDER

SCALE: 3/4" = 1'-0"

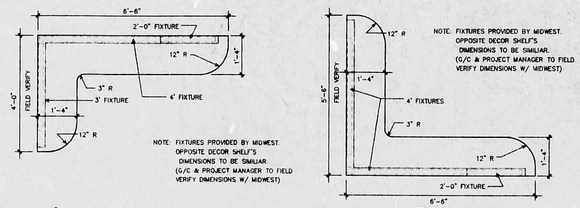

04 DECOR SHELF DETAILS

SCALE: 1/2" = 1'-0"

FIXTURE SCHEDULE

K1 TRACK LIGHT FIXTURE - BALLCRAWL TRACKS TO RECEIVE 75 WATT PAR 30 CAPSALITE LOL # 9233 BKCC

K2 TRACK LIGHT FIXTURE - SHOWROOM TRACKS TO RECEIVE R30 80WATT WHITE. ALL OTHER'S R30 80WATT CAPSALITE LIGHTOLIER LOL # 9223BK

F3 4 FT, 1 LAMP, FLOURESCENT STRIP COLUMBIA CH4-140-LE-120V LAMP: 1-F40CW/SS

F1 2 FT, 1 LAMP, FLOURESCENT STRIP COLUMBIA CH2-120-L-120V LAMP: 1-F20T12/CW

G1 DECORATIVE FIXTURE, CORD SUSPENDED 2'-6" ABOVE TOP OF TABLE HI-LITES 403044 LAMP: 1-50W/R20-PINK

D3 RECESSED INCANDESCENT DOWNLIGHT WITH BAFFLE & TRIM RING PRESCOLITE PBX-1070S LAMP: 1-100A/BO/SS

TRACKS
UBLACK LIGHTOLIER TRACK
2' STARTER TRACK LOL #6000BK
4' STARTER TRACK LOL #6001BK
8' STARTER TRACK #6002BK
8' JOINER TRACK LOL #6003BK
TRACK EXTENSION LOL #6074BK
TRACK ADAPTER LOL #7598BK
CORD PLUG SET FOR TRACK LOL #6082BK
MONOPOINT MOUNT LOL #6193BK
'L' CONNECTOR KIT LOL #6053BK

ALL LIGHTING FIXTURES AND ACCESSORIES BY G.C., ITEMS NOTED IN REMARKS ARE REQUIRED PURCHASES FROM DEALERS ELECTRICAL SUPPLY. PH 972-790-7000

E1 EXTERIOR SURFACE MOUNT - SPAULDING WORI-M400-M7 LAMP: 1-M44/U

R EXISTING TRACK AND/OR FIXTURE TO BE RELOCATED

C1 EXTERIOR SCONCES - AMERICAN LANTERN #4-2022-08 LAMP: 2-150W/PAR38

D1 RECESSED FLUORESCENT DOWNLIGHT WITH BAFFLE & TRIM RING PRESCOLITE CFT632EB-STFBD2 LAMP: #2 WATT TRI-TUBE - SYLVANIA CF42DT/E/IN/841

CEILING LEGEND

- CLG MOUNT BOSE SPEAKER BY OWNER
- PA HANGING BOX SPEAKER BY OWNER
- PA 8" ROUND SPEAKER BY OWNER
- SUPPLY AIR GRILLE
- RETURN AIR GRILLE
- EMERGENCY LIGHTING UNIT
- EXIT UNIT
- RECESSED DOWN LIGHT
- H HANGING LIGHT AT BOOTHS
- 36" FLOURESCENT STRIP (2 BULBS)
- 48" FLOURESCENT STRIP (1 BULB)
- 24" FLOURESCENT STRIP (1 BULB)
- TRACK LIGHT
- TRACK LIGHT WITH EXTENSION WAND
- TRACK LIGHT WITH MONOPOINT MOUNT
- SPOT LIGHT ON TRUSS
- LIGHT TRACK (LENGTH AS SHOWN)
- ARTUP WALLSCONCE
- 2x4 LAY-IN FLOURESCENT FIXTURE W/ ACRYLIC LENSE
- FIXTURE W/ BATTERY BACK-UP AND ACRYLIC LENSE
- 2x4 LAY-IN FLUORESCENT FIXTURE W/ SILVER LENSE
- 2x4 LAY-IN FLUORESCENT FIXTURE W/ BLACK LIGHT LAMPS
- EXISTING FIRE SPRINKLER
- CEILING OUTLET

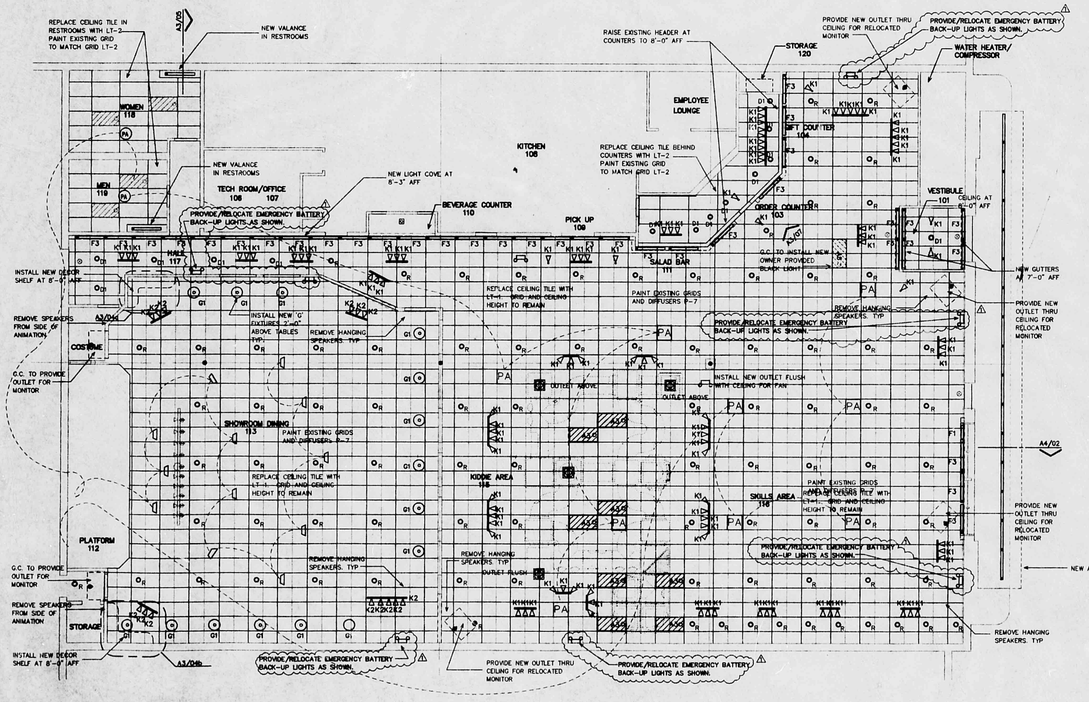

01 REFLECTED CEILING PLAN

SCALE: 1/8" = 1'-0"

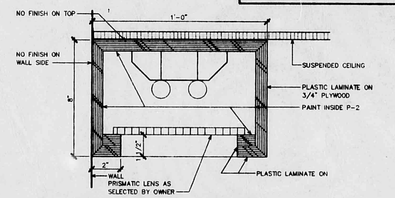

05 LIGHT VALANCE

SCALE: 3" = 1'-0"

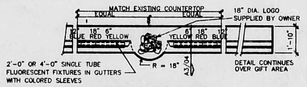

07 ORDER COUNTER HEADER DETAIL

SCALE: 1/4" = 1'-0"

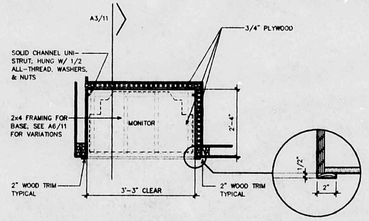

10 STUDIO MONITOR PLAN

SCALE: 1/2" = 1'-0"

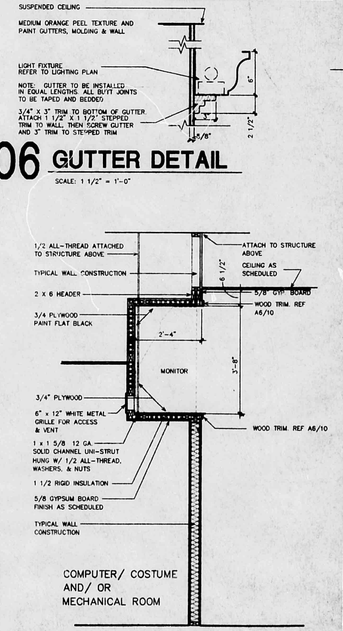

06 GUTTER DETAIL

SCALE: 1 1/2" = 1'-0"

11 STUDIO MONITOR SECTIONS

SCALE: 1/2" = 1'-0"

ALBUQUERQUE BUILDING & SAFETY
SEP 20 1999
U.B.C. PLAN CHECK SECTION

THESE DRAWINGS/SPECS ARE THE SOLE PROPERTY OF BSD ENTERTAINMENT, INC. ANY REPRINT OR USE OF THESE DOCUMENTS FOR ANY PURPOSE WITHOUT THE WRITTEN PERMISSION OF THE ARCHITECT AND BSD ENTERTAINMENT, INC. IS PROHIBITED.

C.T. CHANG AIA
819 WEST ELLIS BLVD, #20
ELLIS, TEXAS 76040

STATE OF NEW MEXICO
C.T. CHANG
No. 3353
REGISTERED ARCHITECT

B&W
BURNSIDE AND WILLIAMS
PROJECT ADMINISTRATOR

CHUCK E. CHEESE'S PIZZA #332 - ALBUQUERQUE, NEW MEXICO
418 WYOMING BLVD.NE - ALBUQUERQUE, NEW MEXICO - 87111

CBO ENTERTAINMENT INC.
4441 WEST AIRPORT FRWY.
IRVING, TEXAS 75062

REFLECTED CEILING PLAN

Date 07/28/99

Revisions
- 08/09/99

Project Number 98-180

Sheet Number A3 of 05

PLAN SHOT TWICE
ONCE ON LIGHT
ONCE ON DARK

CITY OF ALBUQUERQUE
THIS MICROIMAGE IS THE BEST POSSIBLE REPRODUCTION DUE TO THE POOR QUALITY OF THE ORIGINAL DOCUMENT.

R# 79 DATE 1-31-01 OP ESP

CITY OF ALBUQUERQUE
This microimage is certified to be a complete and accurate copy of the original as it appears in the files of the Planning Department and was created in the normal course of business.
The photographic process used meets the Basic Microfilm Standards of the National Micrographics Association (MS115-1977)
Richard Gutrich
DIRECTOR
Margaret D. Garcia
NOTARY PUBLIC
Commission expires: 10/22/2001

D C B A

CITY OF ALBUQUERQUE

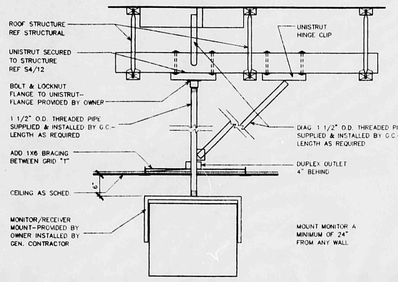

02 MONITOR MOUNT DETAIL

SCALE: 3/4" = 1'-0"

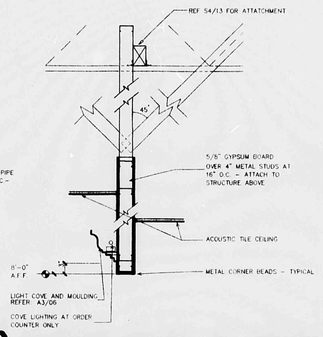

03 HEADER DETAIL AT ORDER

SCALE: 3/4" = 1'-0"

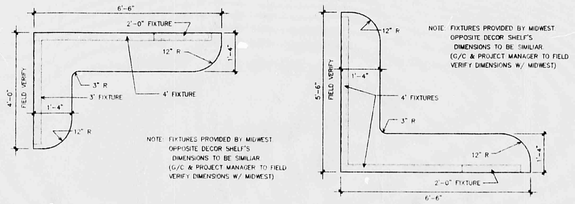

04 DECOR SHELF DETAILS

SCALE: 1/2" = 1'-0"

FIXTURE SCHEDULE

K1 TRACK LIGHT FIXTURE – BALLCRAWL TRACKS TO RECEIVE 75 WATT PAR 30 CAPSALITE LOL # 9233 BKCC

K2 TRACK LIGHT FIXTURE – SHOWROOM TRACKS TO RECEIVE R20 50WATT WHITE. ALL OTHER'S R20 50WATT CAPSALITE LIGHTQUER LOL # 9223BK

F3 4 FT, 1 LAMP, FLOURESCENT STRIP
COLUMBIA CH4-160-UE-120V
LAMP: 1-F40CW/ZS

F1 2 FT, 1 LAMP, FLOURESCENT STRIP
COLUMBIA CH2-120-L-120V
LAMP: 1-F20T12/CW

G1 DECORATIVE FIXTURE, CORD SUSPENDED
2'-6" ABOVE TOP OF TABLE
HI-LITES 403044
LAMP: 1-50W/R20-PINK

D3 RECESSED INCANDESCENT DOWNLIGHT
WITH BAFFLE & TRIM RING
PRESCOLITE PBX-1070S
LAMP: 1-100A/R0/SS

TRACKS
UBLACK LIGHTQUER TRACK
2' STARTER TRACK LOL #6000BK
4' STARTER TRACK LOL #6001BK
8' STARTER TRACK #6002BK
8' JOINER TRACK LOL #6003BK
TRACK EXTENSION LOL #6074BK
TRACK ADAPTER LOL #7589BK
CORD PLUG SET FOR TRACK LOL #6062BK
MONOPOINT MOUNT LOL #6190BK
'L' CONNECTOR KIT LOL #6053BK

ALL LIGHTING FIXTURES AND ACCESSORIES BY G.C., ITEMS NOTED IN REMARKS ARE REQUIRED PURCHASES FROM DEALERS ELECTRICAL SUPPLY. PH 972-790-7000

E1 EXTERIOR SURFACE MOUNT – SPAULDING WGRII-M400-M7
LAMP: 1-M4/U

R EXISTING TRACK AND/OR FIXTURE TO BE RELOCATED

C1 EXTERIOR SCONCES – AMERICAN LANTERN #4-2022-08
LAMP: 2-150W/PAR38

D1 RECESSED FLUORESCENT DOWNLIGHT
WITH BAFFLE & TRIM RING
PRESCOLITE CF1832EB-ST1802
LAMP: 42 WATT TRI-TUBE – SYLVANIA CF42DT/E/IN/841

CEILING LEGEND

- CLG MOUNT BOSE SPEAKER BY OWNER
- HANGING BOX SPEAKER BY OWNER
- 8" ROUND SPEAKER BY OWNER
- SUPPLY AIR GRILLE
- RETURN AIR GRILLE
- EMERGENCY LIGHTING UNIT
- EXIT UNIT
- RECESSED DOWN LIGHT
- HANGING LIGHT AT BOOTHS
- 36" FLOURESCENT STRIP (2 BULBS)
- 48" FLOURESCENT STRIP (1 BULB)
- 24" FLOURESCENT STRIP (1 BULB)
- TRACK LIGHT
- TRACK LIGHT WITH EXTENSION WAND
- TRACK LIGHT WITH MONOPOINT MOUNT
- SPOT LIGHT ON TRUSS
- LIGHT TRACK (LENGTH AS SHOWN)
- ARTUP WALLSCONCE
- 2x4 LAY-IN FLOURESCENT FIXTURE W/ ACRYLIC LENSE
- FIXTURE W/ BATTERY BACK-UP AND ACRYLIC LENSE
- 2x4 LAY-IN FLUORESCENT FIXTURE W/ SILVER LENSE
- 2x4 LAY-IN FLUORESCENT FIXTURE W/ BLACK LIGHT LAMPS
- EXISTING FIRE SPRINKLER
- CEILING OUTLET

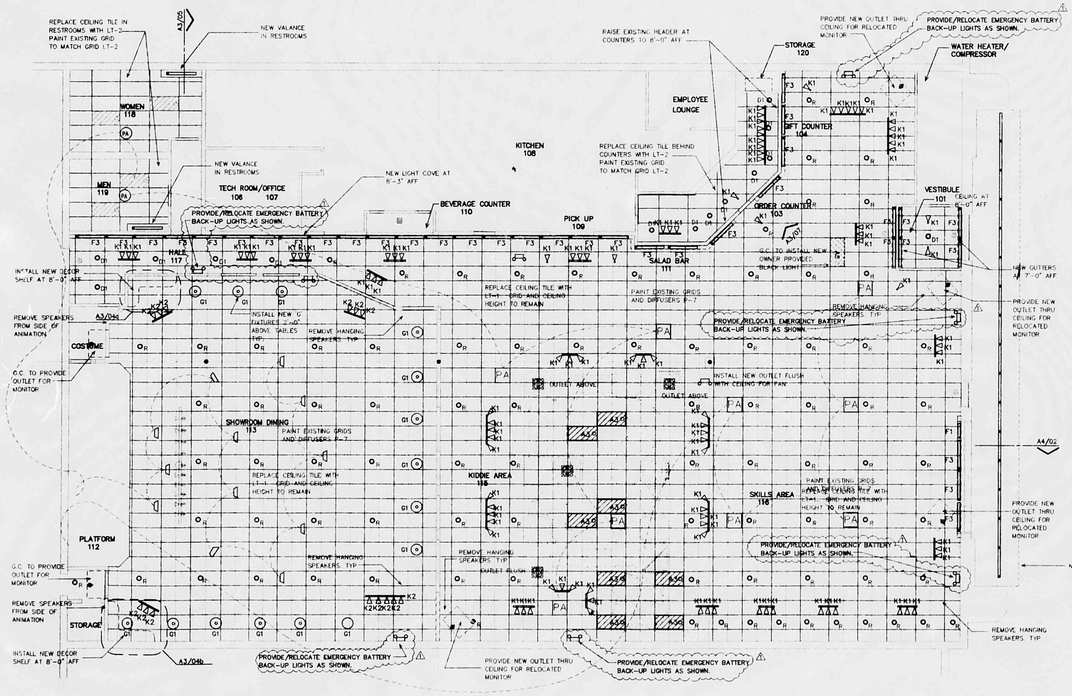

01 REFLECTED CEILING PLAN

SCALE: 1/8" = 1'-0"

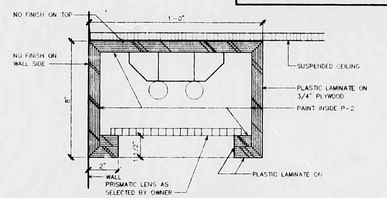

05 LIGHT VALANCE

SCALE: 3" = 1'-0"

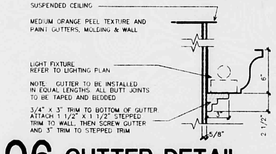

06 GUTTER DETAIL

SCALE: 1 1/2" = 1'-0"

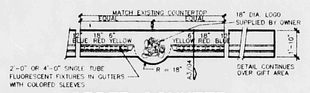

07 ORDER COUNTER HEADER DETAIL

SCALE: 1/4" = 1'-0"

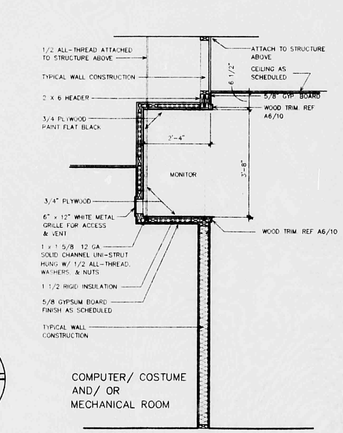

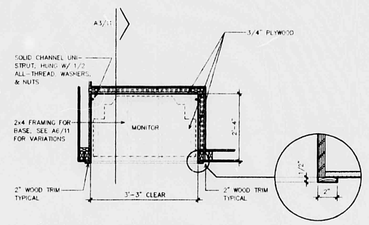

10 STUDIO MONITOR PLAN

SCALE: 1/2" = 1'-0"

11 STUDIO MONITOR SECTIONS

SCALE: 1/2" = 1'-0"

ALBUQUERQUE BUILDING & SAFETY
SEP 20 1999
U.B.C. PLAN CHECK SECTION

C.T. CHANG AIA
1010 WEST EULESS BLVD. #110
EULESS, TEXAS 76040

STATE OF NEW MEXICO
C.T. CHANG
No. 3353
REGISTERED ARCHITECT
7/31/99

B&W BUDSON AND WILLIAMS
PROJECT ADMINISTRATOR

CHUCK E. CHEESE'S PIZZA #332 - ALBUQUERQUE, NEW MEXICO
4418 WYOMING BLVD.NE. - ALBUQUERQUE, NEW MEXICO - 87111
CEC ENTERTAINMENT INC.
4441 WEST AIRPORT FRWY.
IRVING, TEXAS 75062

REFLECTED CEILING PLAN

Date 07/28/99

Revisions
1 09/09/99

Project Number 98-180

Sheet Number A3 of 05

THESE DOCUMENTS ARE THE SOLE PROPERTY OF CEC ENTERTAINMENT, INC. ANY COPYING OR REUSE OF THESE DOCUMENTS FOR PURPOSES OTHER THAN CONSTRUCTION OF THIS PROJECT WITHOUT THE EXPRESS WRITTEN PERMISSION OF THE ARCHITECT AND CEC ENTERTAINMENT, INC. IS PROHIBITED.

PLAN SHOT TWICE
ONCE ON LIGHT
ONCE ON DARK

CITY OF ALBUQUERQUE
THIS MICROIMAGE IS THE BEST POSSIBLE REPRODUCTION DUE TO THE POOR QUALITY OF THE ORIGINAL DOCUMENT.

R# 79 DATE 1-31-01 OP EZP
CITY OF ALBUQUERQUE
This microimage is certified to be a complete and accurate copy of the original as it appears in the files of the Planning Department and was created in the normal course of business.
The photographic process used meets the Basic Microfilm Standards of the National Micrographics Association (MS115-1977)
Richard Suttich
DIRECTOR
Margaret D. Maurice
NOTARY PUBLIC
Commission expires: 10/22/2001

D C B 2 20 12 D

CITY OF ALBUQUERQUE

DECOR SCHEDULE

ITEM	NO.	DESCRIPTION	LOCATION: EXISTS LEAVE IN PLACE	EXISTS REMOVE- HOLD FOR REINSTALL	EXISTS REMOVE- HOLD FOR PICKUP	NEW	REMARKS
D1	0	CD AWARD (CHEESE 2 TOP)					PROVIDE SIMPLEX RECEPTACLE OUTLET @ 6'-6" AFF
D2	1	MUST "C" TV AWARD (1 JERRY ROAD)				O	PROVIDE SIMPLEX RECESSED OUTLET @ 6'-6" AFF
D3	0	CD AWARD (TVA GOTTA PITCH)					PROVIDE SIMPLEX RECESSED OUTLET @ 6'-6" AFF
D4	0	CD AWARD (SAT NITE REV)					
D5	1	MUST "C" TV AWARD (YELLOW SUB)				O	
D6	0	CD AWARD (LT. JOHN'S)					PROVIDE SIMPLEX RECESSED OUTLET @ 6'-6" AFF
D7	0	CD AWARD (BRAIN)					
D8	0	CD AWARD (BAD DOG)					
D9	0	CD AWARD (KAT)					
D10	1	MUST "C" TV AWARD (MUNCH JAM)				O	PROVIDE SIMPLEX RECESSED OUTLET @ 6'-6" AFF
D11	0	CD AWARD (RYTHM RATION)					PROVIDE SIMPLEX RECESSED OUTLET @ 6'-6" AFF
D12	1	GAME SHOW				O	
D13	1	SHOWROOM PICTURE (SKEVE INN)				O	
D14	0	SHOWROOM PICTURE (GROOVEHAVY)					
D15	1	SHOWROOM PICTURE (TV STUDIO)				O	
D16	0	SHOWROOM PICTURE (SPORTS PICTURE)					
D17	1	SHOWROOM PICTURE (SEPIA TONE)				O	
D18	2	FILM REEL PLAYERS				O	
D19	1	FILM STRIPS				O	
D20	1	CLAPBOARD				O	
D21	1	POSTCARD (ITALY)				O	
D22	1	POSTCARD (WILD WEST)				O	
D23	1	POSTCARD (BIG CITY)				O	
D24	1	POSTCARD (HOLLYWOOD)				O	
D25	1	POSTCARD (TROPICS)				O	
D26	1	HOCKEY STICK, PUCK				O	
D27	1	LARGE BAT AND BALL				O	
D28	1	MT. CHUCKMORE				O	
D29	1	CHEESE BUNYAN				O	
D30	0	FLAME BUFFAR					
D31	0	ROLLING BONE					
D32	1	SET OF BALLS				O	

ITEM	NO.	DESCRIPTION	LOCATION: EXISTS LEAVE IN PLACE	EXISTS REMOVE- HOLD FOR REINSTALL	EXISTS REMOVE- HOLD FOR PICKUP	NEW	REMARKS
D33	5	LG CRAYON/SM PEN					
D34	1	LARGE PEN AND PENCIL				O	
D35	0						
D36	0						
D37	0	DRUM COVER					
D38	0						
D39	4	LARGE MAGAZINE COVER				O	
D40	4	SMALL MAGAZINE COVER				O	
D41	0						
D42	1	PORTRAITS (CHUCK)				O	
D43	1	PORTRAITS (HELEN)				O	
D44	1	PORTRAITS (MUNCH)				O	
D45	1	PORTRAITS (PASQUALLY)				O	
D46	1	PORTRAITS (JASKAY)				O	
D47	0						
D48	40	SILK PLANT (TERRA COTTA BALL SCONCE)				O	
D49	0	SILK PLANT (BRASS WALL SCONCE)					
D50	1	SILK PLANT (STANDARD SNEEZE GUARD)				O	
D51	1	SILK PLANT (DRACENA FLOOR PLANT)				O	
D52	1	KID CHECK PLANT				O	BUDGET $000
D53	0						
D54	12	STAR (9")				O	
D55	8	STAR (12")				O	
D56	0	STAR (18")					
D57	1	STAR (24")				O	
D58	0	STAR (36")					
D59	0						
D60	SEA	2" COATRACK				O	
D61	0	MOVIE PAR-ODY POSTERS					
D62	0						
D63	1 SET	ANDY WARHOL TRI-WARHOL				O	
D67	2	COAT RACKS (6')				O	

SIGNAGE SCHEDULE

ITEM	NO.	DESCRIPTION	LOCATION: EXISTS LEAVE IN PLACE	EXISTS REMOVE- HOLD FOR REINSTALL	EXISTS REMOVE- HOLD FOR PICKUP	NEW
S1	1	ENTRANCE SIGN (HOURS OF OP.)				O
S2	1	ENTRANCE SIGN (PHONE'S)	O			
S3	1	ENTRANCE SIGN (PONY OF DIFFERENCE)	O			
S4	1	ENTRANCE SIGN (SMOKING POLICY)				O
S5	1	ENTRANCE AND EXIT DECALS				O
S6	0					
S7	A	MENU HEADER				
S8	1	GIFTS AND PRIZES (STANDARD)				O
S9	0	GIFTS AND PRIZES (SMALL)				
S10	0	GIFTS (SMALL)				
S11	1	SALAD BAR				O
S12	1	BEVERAGES (STANDARD)				O
S13	0	BEVERAGES (SMALL)				
S14	1	PIZZA CIRCLES				O
S15	0					
S16	0	SKEEBALL SCOREBOARD AND HEADER				
S17	0	SKEEBALL HEADER (ONLY)				
S18	1	SHOWROOM SIGN/LOGO (STANDARD)				O
S19	0	SHOWROOM SIGN/LOGO (SMALL)				
S20	48	COLOR SLEEVE UNITS				O
S21	1	LESLIE SAWDEY ARTIFACTS				O
S22	1	RESTROOM DIRECTIONAL				O
S23	1	RESTROOM MARQUEES (MEN & WOMEN)				O
S24	1	RESTROOM OVALS (CHUCK & HELEN)				O
S25	0	ADA SIGNS (STROBE/SAVE)				
S26	1	ADA SIGNS (PLASTIC)				O
S27	0					

ITEM	NO.	DESCRIPTION	LOCATION: EXISTS LEAVE IN PLACE	EXISTS REMOVE- HOLD FOR REINSTALL	EXISTS REMOVE- HOLD FOR PICKUP	NEW
S28	1	LOGO (18" ROUND)				O
S29	0	LOGO (24" ROUND)				
S30	0	LOGO (36" ROUND)				
S31	1	LOGO (24" THUMBCHUCK)				O
S32	2	LOGO (36" THUMBCHUCK)				O
S33	0					
S34	0					
S35	0					
S36	0					
S37	1	CHECKS (22")				O
S37	2	CHECKS (32")				O
S38	0	CHECKS (126")				
S39	0	CHECKS (72")				
S40	0	CHECKS (97")				
S41	0	CHECKS (122")				
S42	0	CHECKS (147")				
S43	0	CHECKS (192")				
S44	0	CHECKS (217")				
S45	0					
S46	0					
S47	1	EXIT ONLY DECAL				O
S48	1	EXIT ONLY SIGN				O
S49	1	OCCUPANCY SIGN (TOTAL)				
S50	1	OCCUPANCY SIGN (AREA)				
S51	0					
S52	0	EMPLOYEE PLAQUES				
S53	0	DELIVERY SIGN				
304						

DOOR SCHEDULE

DOOR NO.	DOOR SIZE	TYPE	MATERIAL	FINISH	FRAME MATERIAL	FRAME FINISH	HARDWARE SET #	NOTES
01	pr. 3'-0" X 7'-0" X 1 3/4"	A	COATED	ALUMIN.	ANODIZED		1	KAWNEER
02	3'-0" X 7'-0" X 1 3/4"	F	COATED	ALUMIN.	ANODIZED		12	KAWNEER
03	3'-0" x 6'-8" x 1 3/4"	B	LP-1	HM	P-2		9	
04	MATCH EXISTING	B	LP-1	EXISTING	P-2		9	
05	MATCH EXISTING	E	LP-1	HM	P-2		3	
06	MATCH EXISTING	E	LP-1	EXISTING	P-2		3	
07	MATCH EXISTING	E	LP-1	EXISTING	P-2		3	
08	MATCH EXISTING	B	LP-1	EXISTING	P-2		11	
09	MATCH EXISTING	B	LP-1	EXISTING	P-2		11	

DOOR TYPES

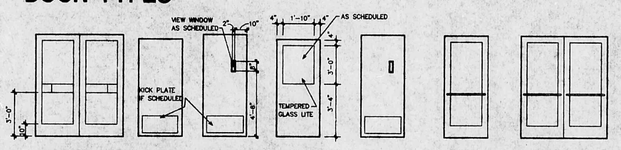

TYPE "A" ALUMINUM ENTRANCE

TYPE "B" SOLID CORE WOOD

TYPE "C" HOLLOW METAL

TYPE "D" HOLLOW METAL

TYPE "E" TRAFFIC DOOR

TYPE "F" ALUMINUM STOREFRONT EXIT

TYPE "G" ALUMINUM ENTRANCE

KAWNEER SPEC:
KAWNEER'S TRIFAB 451 SERIES OR EQUAL DOUBLE GLAZED STICK SYSTEM FABRICATION: 1 3/4" X 4 1/2" WITH DARK BRONZE #40 ANODIZED ALUMN. FINISH.

HARDWARE SCHEDULE

HARDWARE SET NO. 1 – DOUBLE FRONT ENTRY

2	EA	PIVOT	KAWNEER	BOTTOM OFFSET #17 CLR FINISH	
2	EA	PIVOT	KAWNEER	TOP OFFSET #17 CLR FINISH	
2	EA	PIVOT	KAWNEER	INTERMEDIATE #17 CLR FINISH	
2	EA	PULL	KAWNEER	OFFSET PULL #17 CLR FINISH	
2	EA	PANIC	KAWNEER	PANELINE II EXIT DEVICE #16 CLR ANODIZED	
1	EA	CYLINDER	KAWNEER	KEYED	
1	EA	THRESHOLD	KAWNEER	1/2 X 4" MILL FINISH	
2	EA	CLOSER	LCN	1861 SNB DB #33	

HARDWARE SET NO. 2 – DOUBLE ENTRY/LOBBY

2	EA	PIVOT	KAWNEER	BOTTOM OFFSET #17 CLR FINISH	
2	EA	PIVOT	KAWNEER	TOP OFFSET #17 CLR FINISH	
2	EA	PIVOT	KAWNEER	INTERMEDIATE #17 CLR FINISH	
1	EA	PULL	KAWNEER CQ-9	OFFSET PULL #17 CLR FINISH	
2	EA	PUSH	KAWNEER CP-4	EXIT DEVICE #17 CLR FINISH	
1	EA	THRESHOLD	KAWNEER	1/2" X 4" MILL FINISH	
2	EA	CLOSER	LCN #4041	1861 SNB	DB #33

HARDWARE SET NO. 3 – KITCHEN/SERVICE DOORS

HARDWARE BY MANUFACTURER:
STANDARD EASY SWING PIVOTAL HINGE
JAMB GUARDS

HARDWARE SET NO. 4 – EXTERIOR SERVICE DOORS

4	EA	BUTTS	HAGER	#BB-1279	4.5" x 4.5" US32D
1	EA	THRESHOLD	N.GUARD	#295 X WIDTH SCHED.	AL
1	EA	DEAD BOLT	SCHLAGE	#B182N	US26D
1	EA	CLOSER	LCN	#4111SHO SNB	BLACK
1	EA	EXIT ALARM	DETEX	#EA-5005 2049S	
1	EA	PANIC	CORBIN	#3729 HEAVY DUTY SNB	US32D
1	EA	GASKET SET	N.GUARD	#TM137A	
1	EA	SWEEP	N.GUARD	#TM300A	
3	EA	SILENCERS	HAGER	#3070	

HARDWARE SET NO. 5 – EXIT DOOR

3	EA	BUTTS	HAGER	#BB-1279	4.5" x 4.5" NRP US26D
1	EA	THRESHOLD	N.GUARD	#296 x 3"	W/ NEOPRENE AL
1	EA	GASKET SET	N.GUARD	#TM137A	
1	EA	EXIT ALARM	DETEX	#EA-5005 2049S	
1	EA	PANIC	V. DURPIN	#9850 SNB	US26D
3	EA	SILENCERS	HAGER	#3070 SNB	BLACK
1	EA	CLOSER	LCN	#4011	

HARDWARE SET NO. 6 – TOILET ROOMS

3	EA	BUTTS	HAGER	#BB-1279	4.5" x 4.5" US26D
1	EA	CLOSER	LCN	#4011 SNB	BLACK
1	EA	PULL	HAGER	#34L	4" x 16"/12" PULL US28D
1	EA	PUSH PLATE	HAGER	#305	4" x 16" US26D
1	EA	KICK PLATE	HAGER	#190S	10" x 34" PUSH US28D
1	EA	WALL STOP	B.BRASS	#99	US26D
3	EA	SILENCERS	HAGER	#3070	

HARDWARE SET NO. 7 – KITCHEN DOORS

3	EA	BUTTS	HAGER	#1279	4.5" x 4.5" US26D
1	EA	LOCKSET	SCHLAGE	#D53PD	RHODES US26D
1	EA	WALL STOP	B. BRASS	#99	AS REQUIRED US26D
1	EA	KICK PLATE	HAGER	#190S	10" X 34" US32D
3	EA	SILENCERS	HAGER	#3070	

HARDWARE SET NO. 8 – INTERMEDIATE SERVICE DOORS

3	EA	BUTTS	HAGER	#BB-1279	4.5" x 4.5" NRP US26D
1	EA	LOCKSET	SCHLAGE	#D53PD	RHODES US26D
1	EA	THRESHOLD	N.GUARD	#322 x WIDTH SCHEDULED	AL
1	EA	SWEEP	N.GUARD	#8300SA x WIDTH SCHEDULED	
3	EA	SILENCERS	HAGER	#3070	

HARDWARE SET NO. 9 – TECH, COMPUTER, COSTUME, OFFICE & JANITOR

3	EA	BUTTS	HAGER	#BB-1279	4.5" x 4.5" US26D
1	EA	LOCKSET	SCHLAGE	#D53PD	RHODES US26D
1	EA	CLOSER	LCN	#1461	SNB BLACK
1	EA	WALL STOP	B.BRASS	#99	AS REQUIRED US26D
1	EA	KICK PLATE	HAGER	#190S	10" x 34" US26D
3	EA	SILENCERS	HAGER	#3070	

HARDWARE SET NO. 10 – OFT STORAGE DOOR

3	EA	BUTTS	HAGER	#BB-1279	4.5" x 4.5" US26D
1	EA	LOCKSET	SCHLAGE	#D80PD	RHODES US26D
1	EA	CLOSER	LCN	#1461	SNB BLACK
1	EA	WALL STOP	B.BRASS	#99	AS REQUIRED US26D
3	EA	SILENCERS	HAGER	#3070	

HARDWARE SET NO. 11 – SINGLE TOILET DOOR

3	EA	BUTTS	HAGER	#BB-1279	4.5" x 4.5" US26D
1	EA	PRIVACYSET	SCHLAG.	#D40S	RHODES US26D
1	EA	CLOSER	LCN	#1461	SNB BLACK
1	EA	WALL STOP	B.BRASS	#99	AS REQUIRED US26D
3	EA	SILENCERS	HAGER	#3070	

HARDWARE SET NO. 12 – STOREFRONT EXIT DOOR

3	EA	PIVOTS BY DOOR MANUFACTURER			
1	EA	THRESHOLD	N.GUARD	#896 X WIDTH SCHEDULED /	NEOPRENE
1	EA	GASKET SET	N.GUARD	#6050	
1	EA	EXIT ALARM	DETEX	#EA-5005 2049S	
1	EA	PANIC	V. DURPIN	#9850 SNB	US26D
1	EA	CLOSER	LCN	#1461 SNB FINISH TO MATCH DOOR	

KEY ALL LOCKS ON DAY OF TURNOVER. THE DOORS SHOULD BE KEYED AS FOLLOWED:

ONE GRAND MASTER (ALL OF THE LOCKS CAN BE OPENED WITH THIS KEY).
ONE KEY FOR ALL INTERIOR DOORS (COMPRESSOR ROOM IS CONSIDERED AN INTERIOR DOOR).
ONE KEY FOR TECH ROOM (ALSO ON INTERIOR DOOR KEY).
ONE KEY FOR COSTUME ROOM (ALSO ON INTERIOR DOOR KEY).
ONE KEY FOR FRONT DOOR.

COPIES OF EACH KEY:
GRAND MASTER (1)
INTERIOR DOOR KEY (3)
TECH ROOM KEY (3)
COSTUME ROOM KEY (3)
FRONT DOOR KEY (3)

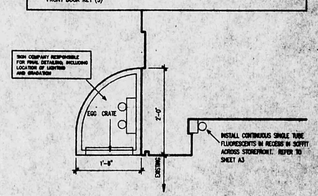



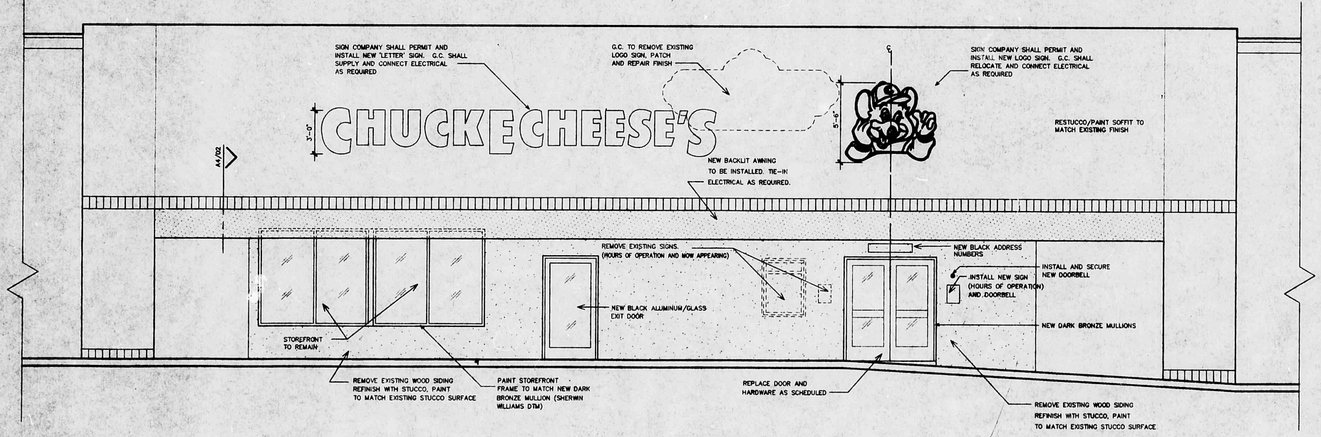



ALBUQUERQUE BUILDING & SAFETY
SEP 2 0 1999
U.B.C. PLAN CHECK SECTION

C.T. CHANG AIA
STATE OF NEW MEXICO
C.T. CHANG No. 3358
REGISTERED ARCHITECT

B&W ARCHITECTURE
PROJECT ADMINISTRATION

CHUCK E. CHEESE'S PIZZA #832 - ALBUQUERQUE, NEW MEXICO
4416 WYOMING BLVD.NE - ALBUQUERQUE, NEW MEXICO - 87111
GGC ENTERTAINMENT, INC.
4441 WEST AIRPORT FREEWAY
IRVING, TEXAS 75062

EXTERIOR ELEVATION AND SCHEDULES

Date 07/26/99
Revisions
Project Number 98-180
Sheet Number A4
of 05

PLAN SHOT TWICE
ONCE ON LIGHT
ONCE ON DARK

CITY OF ALBUQUERQUE
THIS MICROIMAGE IS THE BEST POSSIBLE REPRODUCTION DUE TO THE POOR QUALITY OF THE ORIGINAL DOCUMENT.

R# 79 DATE 1-31-01 OP ESP

CITY OF ALBUQUERQUE

This microimage is certified to be a complete and accurate copy of the original as it appears in the files of the Planning Department and was created in the normal course of business.

The photographic process used meets the Basic Microfilm Standards of the National Micrographics Association (MS115-1977)

Richard Gutsch
DIRECTOR

NOTARY PUBLIC

Commission expires: 10/22/2001

D 2 C 20 B 10 12

CITY OF ALBUQUERQUE

C D

DECOR SCHEDULE

ITEM NO.		DESCRIPTION	LOCATION EXISTS LEAVE IN PLACE	EXISTS REMOVE- HOLD FOR REINSTALL	EXISTS REMOVE- HOLD FOR PICKUP	NEW	REMARKS
D1	0	CD AWARD (CHEESE 2 TOP)					PROVIDE SNIPPER RECESSED OUTLET @ 8'-6" AFF
D2	1	MUST 'C' TV AWARD (FLABBY ROAD)				O	PROVIDE SNIPPER RECESSED OUTLET @ 8'-6" AFF
D3	0	CD AWARD (IVA GOTTA PIZZA)					PROVIDE SNIPPER RECESSED OUTLET @ 8'-6" AFF
D4	0	CD AWARD (EAT-NET RET)					
D5	1	MUST 'C' TV AWARD (YELLOW SUB)				O	
D6	0	CD AWARD (LET JAMMER)					PROVIDE SNIPPER RECESSED OUTLET @ 8'-6" AFF
D7	0	CD AWARD (BRAWN)					
D8	0	CD AWARD (BAD DOG)					
D9	0	CD AWARD (RAP)					
D10	1	MUST 'C' TV AWARD (MUNCH JAM)				O	PROVIDE SNIPPER RECESSED OUTLET @ 8'-6" AFF
D11	0	CD AWARD (RYTHM RATION)					PROVIDE SNIPPER RECESSED OUTLET @ 8'-6" AFF
D12	1	GAME SHOW				O	
D13	1	SHOWROOM PICTURE (DRIVE INN)				O	
D14	0	SHOWROOM PICTURE (BROADWAY)					
D15	1	SHOWROOM PICTURE (TV STUDIO)				O	
D16	0	SHOWROOM PICTURE (SPORTS PICTURE)					
D17	1	SHOWROOM PICTURE (SEPIA TONE)				O	
D18	2	FILM REEL PAINTERS				O	
D19	1	FILM STRIPS				O	
D20	1	CLAPBOARD				O	
D21	1	POSTCARD (TAL.)				O	
D22	1	POSTCARD (MID. WEST)				O	
D23	1	POSTCARD (BIG CITY)				O	
D24	1	POSTCARD (HOLLYWOOD)				O	
D25	1	POSTCARD (TROPICS)				O	
D26	1	HOCKEY STICK PUCK				O	
D27	1	LARGE BAT AND BALL				O	
D28	1	MT. CHUCKMORE				O	
D29	1	CHEESE GUITAR				O	
D30	0	FLAME GUITAR					
D31	0	ROLLING BONE					
D32	1	SET OF BALLS				O	
D33	5	LG. CRAYON/SM. PEN				O	
D34	1	LARGE PEN AND PENCIL				O	
D35	0						
D36	0						
D37	0	DRUM COVER					
D38	0						
D39	6	LARGE MAGAZINE COVER				O	
D40	4	SMALL MAGAZINE COVER				O	
D41	0						
D42	1	PORTRAITS (CHUCK)				O	
D43	1	PORTRAITS (HELEN)				O	
D44	1	PORTRAITS (MUNCH)				O	
D45	1	PORTRAITS (PIZODULE)				O	
D46	1	PORTRAITS (JASPER)				O	
D47	0						
D48	40	SILK PLANT (TERRA COTTA WALL SCONCE)				O	
D49	0	SILK PLANT (BRASS WALL SCONCE)					
D50	1	SILK PLANT (STANDARD SWEEP GUARD)				O	
D51	1	SILK PLANT (DRACINEA FLOOR PLANT)				O	
D52	1	KID CHEESE PLANT				O	BUDGET 6,000
D53	0						
D54	12	STAR (6")				O	
D55	8	STAR (12")				O	
D56	0	STAR (18")					
D57	1	STAR (24")				O	
D58	0	STAR (48")					
D59	0						
D60	2EA.	2 COAT RACK				O	
D61	0	MOVIE PARODY POSTERS					
D62	0						
D63	1SET	ANDY WARHOL TV - WARHOL				O	
D67	2	COAT RACK (6)				O	

SIGNAGE SCHEDULE

ITEM NO.		DESCRIPTION	LOCATION EXISTS LEAVE IN PLACE	EXISTS REMOVE- HOLD FOR REINSTALL	EXISTS REMOVE- HOLD FOR PICKUP	NEW
S1	1	ENTRANCE SIGN (HOURS OF OP.)				O
S2	1	ENTRANCE SIGN (PROMISE)		O		
S3	1	ENTRANCE SIGN (PAY IK DIFFERENCE)		O		
S4	1	ENTRANCE SIGN (SMOKING POLICY)				O
S5	1	ENTRANCE AND EXIT DECALS				O
S6	0					
S7	0	MENU HEADER				
S8	1	GIFTS AND PRIZES (STANDARD)				O
S9	0	GIFTS AND PRIZES (SMALL)				
S10	0	GIFTS (SMALL)				
S11	1	SALAD BAR				
S12	1	BEVERAGES (STANDARD)				O
S13	0	BEVERAGES (SMALL)				
S14	1	PIZZA CIRCLES				O
S15	0					
S16	0	SKEEBALL SCOREBOARD AND HEADER				
S17	0	SKEEBALL HEADER (ONLY)				
S18	1	SHOWROOM SIGN/LOGO (STANDARD)				O
S19	0	SHOWROOM SIGN/LOGO (SMALL)				
S20	45	COLOR SLEEVE UNITS				O
S21	1	LESLIE DAVIES ARTIFACTS				O
S22	1	RESTROOM DIRECTIONAL				O
S23	1	RESTROOM MARQUEE (MEN & WOMEN)				O
S24	1	RESTROOM DUALS (CHUCK & HELEN)				O
S25	0	ADA SIGNS (PROGRESSIVE)				
S26	1	ADA SIGNS (PLASTIC)				O
S27	0					

ITEM NO.		DESCRIPTION	LOCATION EXISTS LEAVE IN PLACE	EXISTS REMOVE- HOLD FOR REINSTALL	EXISTS REMOVE- HOLD FOR PICKUP	NEW
S28	1	LOGO (18" ROUND)				O
S29	0	LOGO (26" ROUND)				
S30	0	LOGO (36" ROUND)				
S31	1	LOGO (24" THUMBTACK)				O
S32	2	LOGO (38" THUMBTACK)				O
S33	0					
S34	0					
S35	0					
S36	1	CHECKS (22")				O
S37	2	CHECKS (32")				O
S38	0	CHECKS (52")				
S39	0	CHECKS (72")				
S40	0	CHECKS (97")				
S41	0	CHECKS (122")				
S42	0	CHECKS (147")				
S43	0	CHEY. 2 (180")				
S44	0	CHECKS (217")				
S45	0					
S46	0					
S47	0	EXIT ONLY DECAL				O
S48	2	EXIT ONLY SIGN				O
S49	1	OCCUPANCY SIGN (TOTAL)				
S50	3	OCCUPANCY SIGN (AREA)				
S51	0					
S52	0	EMPLOYEE PLAQUES				
S53	C	DELIVERY SIGN				
S54						

DOOR SCHEDULE

DOOR NO.	DOOR SIZE	TYPE MATERIAL	TYPE FINISH	FRAME MATERIAL	FRAME FINISH	HARD WARE SET #	NOTES
01	6'- 3"-0" X 7'-0" X 1 3/4"	A	COATED	ALUMN	ANODIZED	1	KAWNEER
02	3'-0" X 7'-0" X 1 3/4"	F	COATED	ALUMN	ANODIZED	12	KAWNEER
03	3'-0" x 6'-8" x 1 3/4"	B	LP-1	HM	P-2	9	
04	MATCH EXISTING	B	LP-1	EXISTING	P-2	9	
05	MATCH EXISTING	E	LP-1	HM	P-2	3	
06	MATCH EXISTING	E	LP-1	EXISTING	P-2	3	
07	MATCH EXISTING	E	LP-1	EXISTING	P-2	3	
08	MATCH EXISTING	B	LP-1	EXISTING	P-2	11	
09	MATCH EXISTING	B	LP-1	EXISTING	P-2	11	

DOOR TYPES

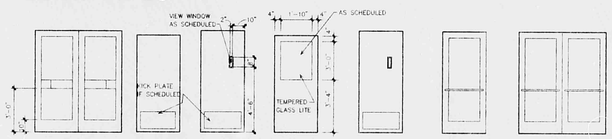

KAWNEER SPEC
KAWNEER'S TRIFAB 451 SERIES OR
EQUAL DOUBLE GLAZED STICK SYSTEM
FABRICATION 1 3/4" X 4 1/2" WITH
DARK BRONZE #40 ANODIZED ALUMN.
FINISH

HARDWARE SCHEDULE

HARDWARE SET NO. 1 – DOUBLE FRONT ENTRY

2	EA PIVOT	KAWNEER	BOTTOM OFFSET	#17 CLR	FINISH
2	EA PIVOT	KAWNEER	TOP OFFSET	#17 CLR	FINISH
2	EA PIVOT	KAWNEER	INTERMEDIATE	#17 CLR	FINISH
2	EA PULL	KAWNEER	OFFSET PULL	#17 CLR	FINISH
2	EA PANIC	KAWNEER PANELINE II	EXIT DEVICE	#14 CLR	ANODIZED
1	EA CLUNDER	KAWNEER	KEYED		
1	EA THRESHOLD	KAWNEER	1/2" X 4" MILL FINISH		
2	EA CLOSER	LCN #4041	18TJ SNB	DB #33	

HARDWARE SET NO. 2 – DOUBLE ENTRY/LOBBY

2	EA PIVOT	KAWNEER	BOTTOM OFFSET	#17 CLR	FINISH
2	EA PIVOT	KAWNEER	TOP OFFSET	#17 CLR	FINISH
2	EA PIVOT	KAWNEER	INTERMEDIATE	#17 CLR	FINISH
2	EA PULL	KAWNEER CO-9	OFFSET PULL	#17 CLR	FINISH
2	EA PUSH	KAWNEER CP-II	EXIT DEVICE	#17 CLR	FINISH
1	EA THRESHOLD	KAWNEER	1/2" X 4" MILL FINISH		
2	EA CLOSER	LCN #4041	18TJ SNB	DB #33	

HARDWARE SET NO. 3 – KITCHEN/SERVICE DOORS

HARDWARE BY MANUFACTURER:
STANDARD EASY-SWING PIVOTAL HINGE
JAMB GUARDS

HARDWARE SET NO. 4 – EXTERIOR SERVICE DOORS

4	EA BUTTS	HAGER	#BB-1279	4.5" x 4.5"	US32D
1	EA THRESHOLD	N.GUARD	#325 X WIDTH SCHED		AL
1	EA DEAD BOLT	SCHLAGE	#B180N		US26D
1	EA CLOSER	LCN	#4116HO	SNB	BLACK
1	EA EXIT ALARM	DETEX	#EA-500S	2049S	
1	EA PANIC	CORBIN	#3729	HEAVY DUTY SNB	US32D
1	EA GASKET SET	N.GUARD	#TM137A		
1	EA SWEEP	N.GUARD	#TM200A		
3	EA SILENCERS	HAGER	#307D		

HARDWARE SET NO. 5 – EXIT DOOR

3	EA BUTTS	HAGER	#BB-1279	4.5" x 4.5" NRP	US26D
1	EA THRESHOLD	N.GUARD	#896 x .5"	W/ NEOPRENE	AL
1	EA GASKET SET	N.GUARD	#TM137A		
1	EA EXIT ALARM	DETEX	#EA-500S	2049S	
1	EA PANIC	V. DURPIN	#886D	SNB	US26D
3	EA SILENCERS	HAGER	#307D		
1	EA CLOSER	LCN	#4011	SNB	BLACK

HARDWARE SET NO. 6 – TOILET ROOMS

3	EA BUTTS	HAGER	#BB-1279	4.5" x 4.5"	US26D
1	EA CLOSER	LCN	#4011	SNB	BLACK
1	EA PULL	HAGER	#34L	4" x 16"/12" PULL	US26D
1	EA PUSH PLATE	HAGER	#305	4" x 16"	US26D
1	EA KICK PLATE	HAGER	#190S	10" x 34" PUSH	US26D
1	EA WALL STOP	B.BRASS	#W9		US26D
3	EA SILENCERS	HAGER	#307D		

HARDWARE SET NO. 7 – KITCHEN DOORS

3	EA BUTTS	HAGER	#1279	4.5" x 4.5"	US26D
1	EA LOCKSET	SCHLAGE	#D53PD	RHODES	US26D
1	EA WALL STOP	B. BRASS	#W9	AS REQUIRED	US26D
1	EA KICK PLATE	HAGER	#190S	10" x 34"	US32D
3	EA SILENCERS	HAGER	#307D		

HARDWARE SET NO. 8 – INTERMEDIATE SERVICE DOORS

3	EA BUTTS	HAGER	#BB-1279	4.5" x 4.5" NRP	US26D
1	EA LOCKSET	SCHLAGE	#D53PD	RHODES	US26D
1	EA THRESHOLD	N.GUARD	#327 x WIDTH	SCHEDULED	AL
1	EA SWEEP	N.GUARD	#TM200A x WIDTH	SCHEDULED	
3	EA SILENCERS	HAGER	#307D		

HARDWARE SET NO. 9 – TECH, COMPUTER, COSTUME, OFFICE & JANITOR

3	EA BUTTS	HAGER	#BB-1279	4.5" x 4.5"	US26D
1	EA LOCKSET	SCHLAGE	#D80PD	RHODES	US26D
1	EA CLOSER	LCN	#1461	SNB	BLACK
1	EA WALL STOP	B.BRASS	#W9	AS REQUIRED	US26D
1	EA KICK PLATE	HAGER	#190S	10" x 34"	US26D
3	EA SILENCERS	HAGER	#307D		

HARDWARE SET NO. 10 – GIFT STORAGE DOOR

3	EA BUTTS	HAGER	#BB-1279	4.5" x 4.5"	US26D
1	EA LOCKSET	SCHLAGE	#D80PD	RHODES	US26D
1	EA CLOSER	LCN	#1461	SNB	BLACK
1	EA WALL STOP	B.BRASS	#W9	AS REQUIRED	US26D
3	EA SILENCERS	HAGER	#307D		

HARDWARE SET NO. 11 – SINGLE TOILET DOOR

3	EA BUTTS	HAGER	#BB-1279	4.5" x 4.5"	US26D
1	EA PRIVACY SET	SCHLAGE	#D40S	RHODES	US26D
1	EA CLOSER	LCN	#1461	SNB	BLACK
1	EA WALL STOP	B.BRASS	#W9	AS REQUIRED	US26D
3	EA SILENCERS	HAGER	#307D		

HARDWARE SET NO. 12 – STOREFRONT EXIT DOOR

3	EA PIVOTS BY DOOR MANUFACTURER				
1	EA THRESHOLD	N.GUARD	#896 X WIDTH	SCHEDULED /	NEOPRENE
1	EA GASKET SET	N.GUARD	#TM50		
1	EA EXIT ALARM	DETEX	#EA-500S	2049S	
1	EA PANIC	V. DURPIN	#886D	SNB	US26D
1	EA CLOSER	LCN	#1461	SNB FINISH TO MATCH DOOR	

KEY ALL LOCKS ON DAY OF TURNOVER. THE DOORS SHOULD BE KEYED AS FOLLOWED

ONE GRAND MASTER (ALL OF THE LOCKS CAN BE OPENED WITH THIS KEY)
ONE KEY FOR ALL INTERIOR DOORS (COMPRESSOR ROOM IS CONSIDERED AN INTERIOR DOOR)
ONE KEY FOR TECH ROOM (ALSO IN INTERIOR DOOR KEY)
ONE KEY FOR COSTUME ROOM (ALSO ON INTERIOR DOOR KEY)
ONE KEY FOR FRONT DOOR

COPIES OF EACH KEY:
GRAND MASTER (1)
INTERIOR DOOR KEY (3)
TECH ROOM KEY (1)
COSTUME ROOM KEY (1)
FRONT DOOR KEY (3)

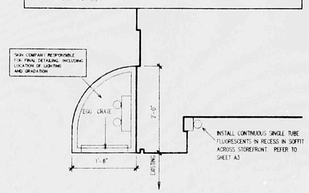

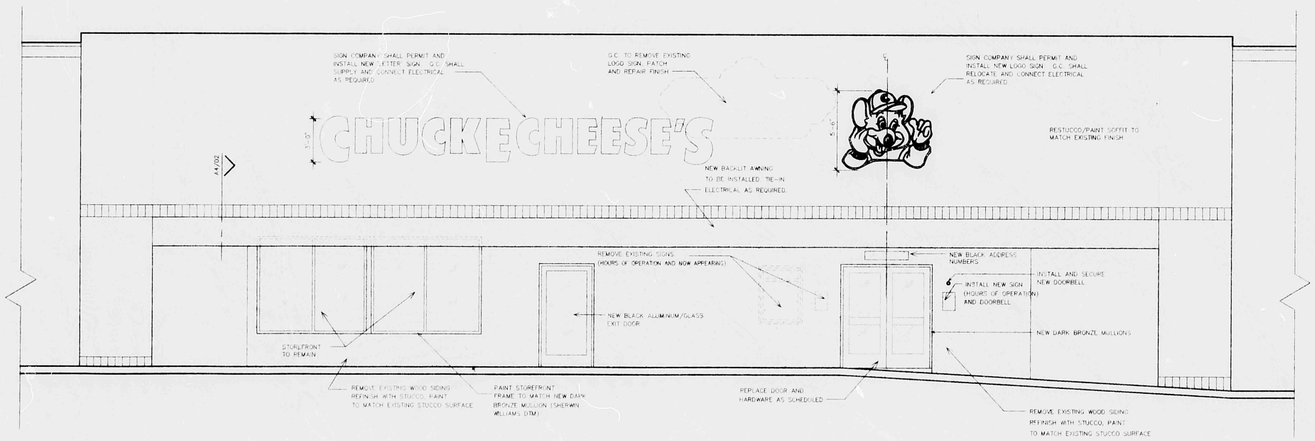

01 WEST ELEVATION
SCALE: 1/4" - 1'-0"

02 AWNING SECTION
SCALE: 3/4" - 1'-0"

BUILDING & SAFETY
SEP 2 0 1999
PLAN CHECK SECTION

THESE DOCUMENTS ARE THE SOLE PROPERTY OF CEC ENTERTAINMENT, INC. ANY COPYING OR REUSE OF THESE DOCUMENTS FOR PURPOSE OTHER THAN CONSTRUCTION OF THIS PROJECT WITHOUT THE EXPRESS WRITTEN PERMISSION OF THE ARCHITECT AND CEC ENTERTAINMENT, INC. IS PROHIBITED

C.T. CHANG AIA
1010 WEST EULESS BLVD., #110
EULESS, TEXAS 76040

STATE OF NEW MEXICO
C.T. CHANG
No. 3353
REGISTERED ARCHITECT
7-30-99

BURSON AND WILLIAMS
PROJECT ADMINISTRATOR

CHUCK E. CHEESE'S PIZZA #332 - ALBUQUERQUE, NEW MEXICO
4418 WYOMING BLVD.NE - ALBUQUERQUE, NEW MEXICO - 87111

CEC ENTERTAINMENT INC.
4441 WEST AIRPORT FRWY.
IRVING, TEXAS. 75062

EXTERIOR ELEVATION AND SCHEDULES

Date 07/28/99

Revisions

Project Number 98-180

Sheet Number A4 of 05

PLAN SHOT TWICE
ONCE ON LIGHT
ONCE ON DARK

CITY OF ALBUQUERQUE
THIS MICROIMAGE IS THE BEST POSSIBLE REPRODUCTION DUE TO THE POOR QUALITY OF THE ORIGINAL DOCUMENT.

R- 771 DATE 1-31-01 OP

CITY OF ALBUQUERQUE
This microimage is certified to be a complete and accurate copy of the original as it appears in the files of the Planning Department and was created in the normal course of business.
The photographic process used meets the Basic Microfilm Standards of the National Micrographics Association (MS115-1977)
Richard Griffith
DIRECTOR
Margaret D. Garcia
NOTARY PUBLIC
Commission expires: 10/22/2001

D C b 12 | CITY OF ALBUQUERQUE D
2 20 10

BUILDING & SAFETY PLANS 4 of 5

ADD: 4418 WYOMING BLVD. N.E.

DES: REMODEL

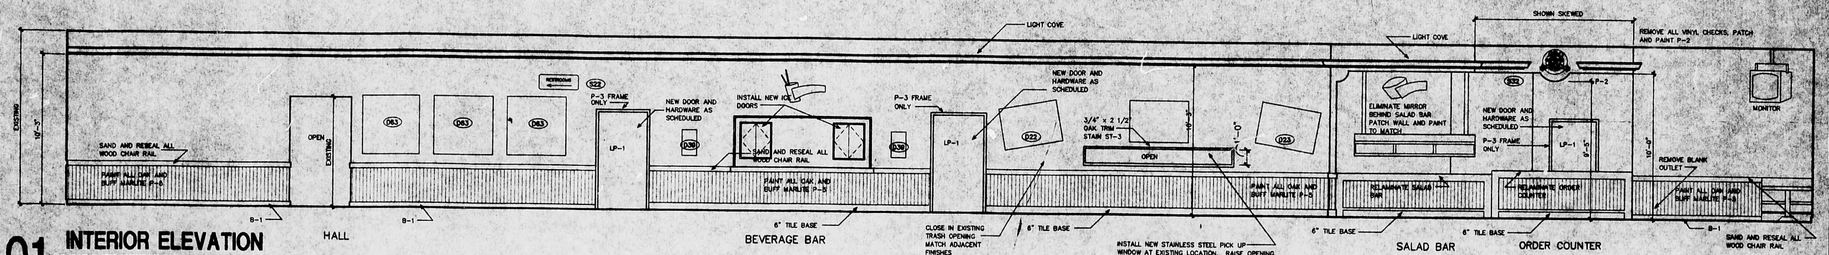

01 INTERIOR ELEVATION

SCALE : 1/4" = 1'-0"

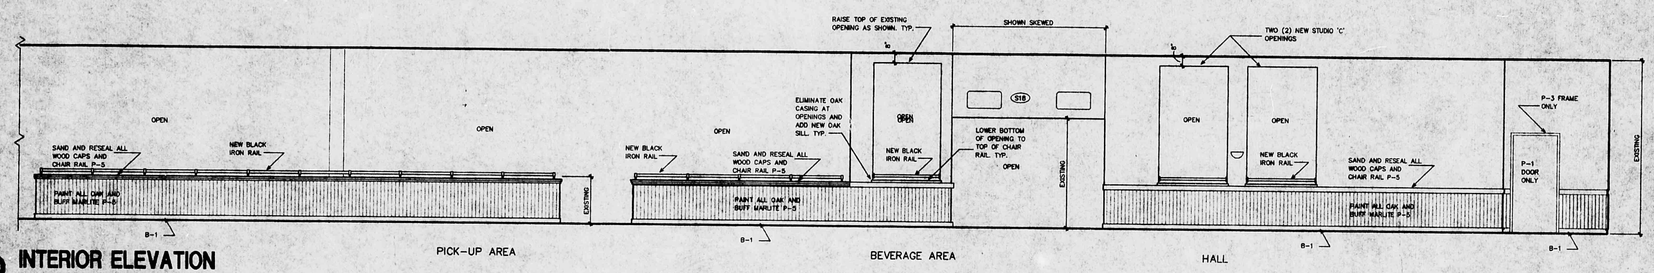

02 INTERIOR ELEVATION

SCALE : 1/4" = 1'-0"

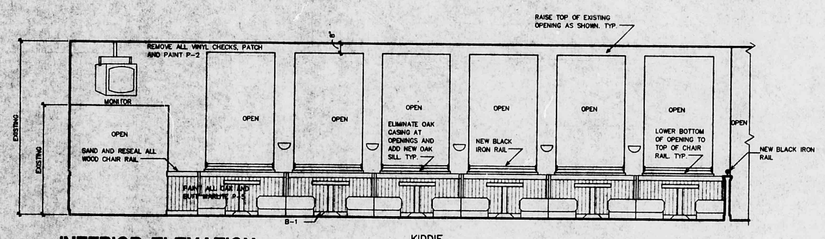

03 INTERIOR ELEVATION

SCALE : 1/4" = 1'-0"

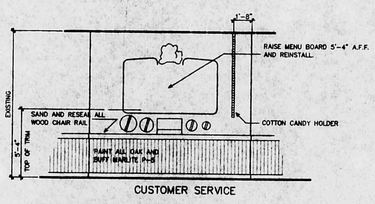

04 INTERIOR ELEVATION

SCALE : 1/4" = 1'-0"

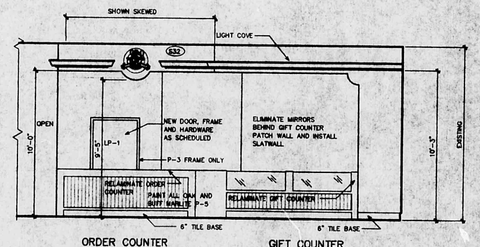

06 INTERIOR ELEVATION

SCALE : 1/4" = 1'-0"

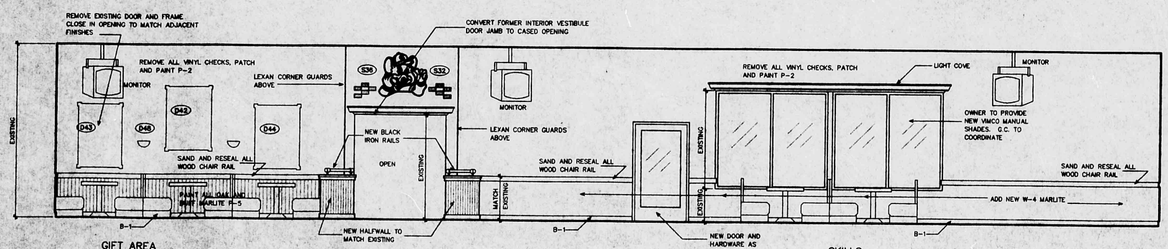

05 INTERIOR ELEVATION

SCALE : 1/4" = 1'-0"

07 KEY PLAN

N.T.S

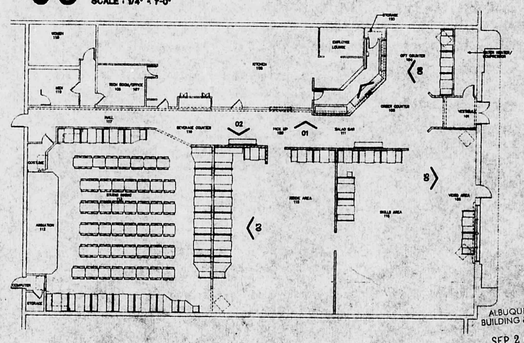






Date 07/28/99

Revisions

Project Number 98-180

Sheet Number A5 of 05

PLAN SHOT TWICE
ONCE ON LIGHT
ONCE ON DARK

CITY OF ALBUQUERQUE
THIS MICROIMAGE IS THE BEST POSSIBLE REPRODUCTION DUE TO THE POOR QUALITY OF THE ORIGINAL DOCUMENT.

R# 772 DATE 1-31-01 OP EDP

CITY OF ALBUQUERQUE

This microimage is certified to be a complete and accurate copy of the original as it appears in the files of the Planning Department and was created in the normal course of business.

The photographic process used meets the Basic Microfilm Standards of the National Micrographics Association (MS115-1977)

Richard Dutch
DIRECTOR

Margaret D. Garcia
NOTARY PUBLIC

Commission expires: 10/22/2001

D 2 C 20 b 10 12

CITY OF ALBUQUERQUE

D

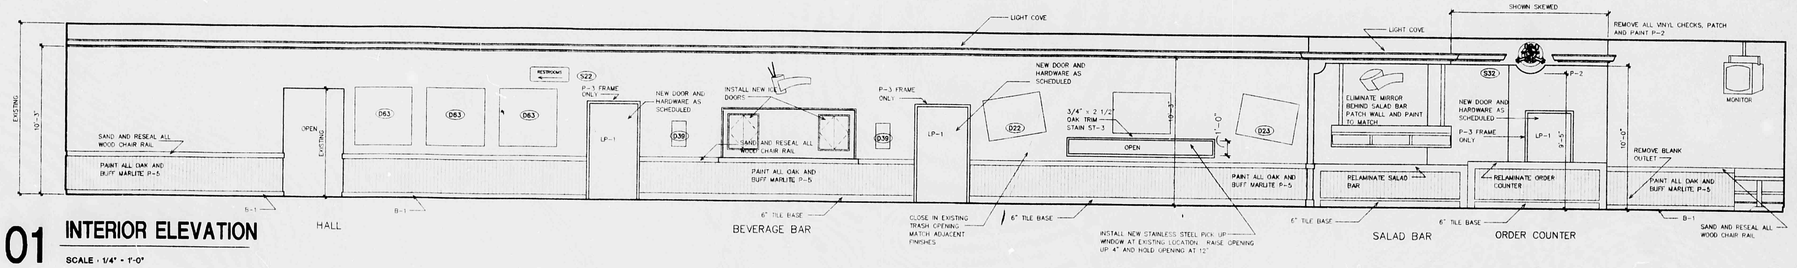

01 INTERIOR ELEVATION

SCALE : 1/4" = 1'-0"

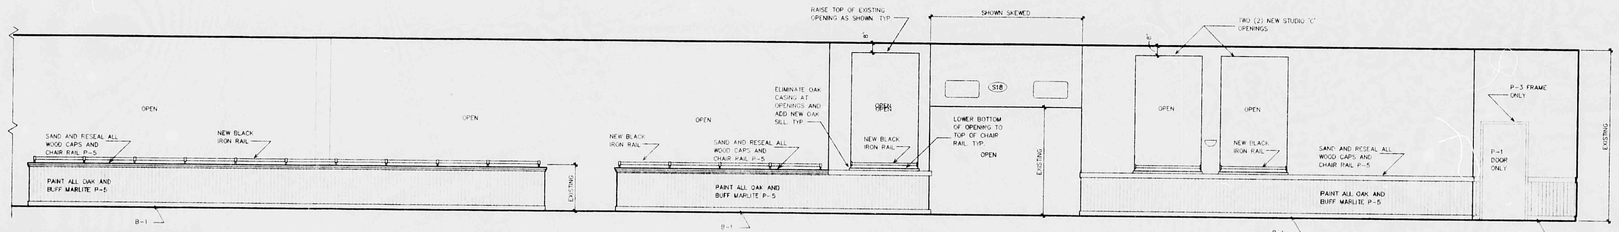

02 INTERIOR ELEVATION

SCALE : 1/4" = 1'-0"

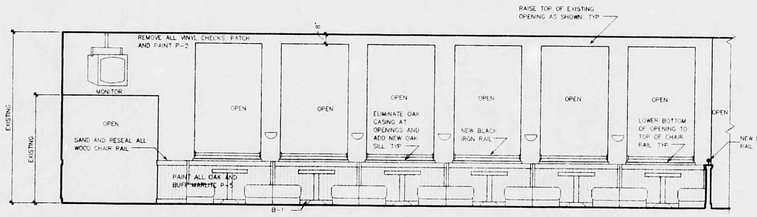

03 INTERIOR ELEVATION

SCALE : 1/4" = 1'-0"

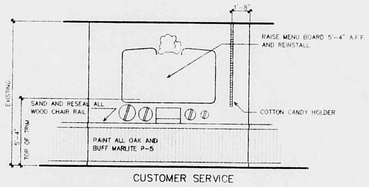

04 INTERIOR ELEVATION

SCALE : 1/4" = 1'-0"

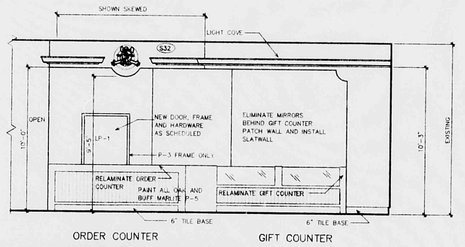

06 INTERIOR ELEVATION

SCALE : 1/4" = 1'-0"

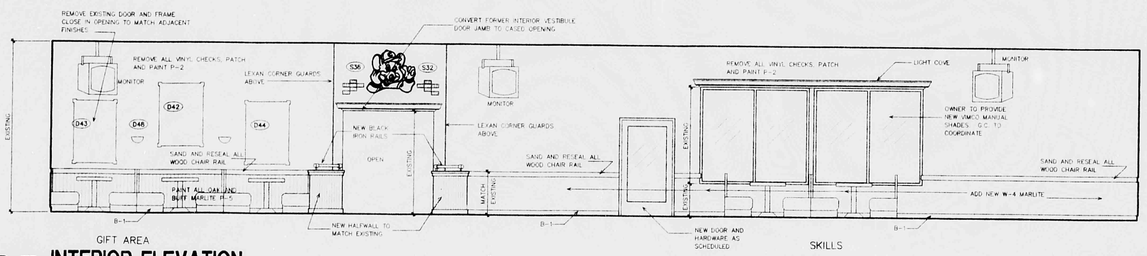

05 INTERIOR ELEVATION

SCALE : 1/4" = 1'-0"

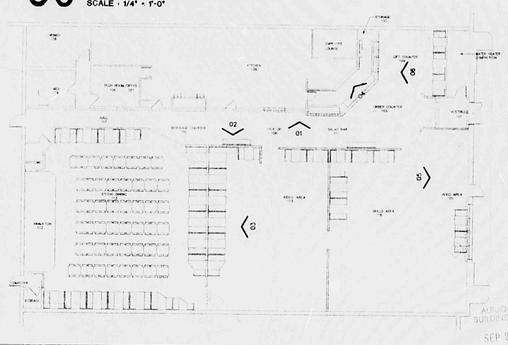

07 KEY PLAN

N.T.S

C.T. CHANG AIA
1010 WEST EULESS BLVD., #110
EULESS, TEXAS 76040

STATE OF NEW MEXICO
C.T. CHANG
No. 3353
REGISTERED ARCHITECT

B&W
BURSON AND WILLIAMS
PROJECT ADMINISTRATOR

CHUCK E. CHEESE'S PIZZA #332 - ALBUQUERQUE
418 WYOMING BLVD.,NE - ALBUQUERQUE, NEW MEXICO - 87111
CEC ENTERTAINMENT INC.
4441 WEST AIRPORT FREEWAY
IRVING, TEXAS. 75062

INTERIOR ELEVATIONS

Date
07/28/99

Revisions

Project Number
98-180

Sheet Number
A5
of 05

PLAN SHOT TWICE
ONCE ON LIGHT
ONCE ON DARK

CITY OF ALBUQUERQUE
THIS MICROIMAGE IS THE BEST POSSIBLE REPRODUCTION DUE TO THE POOR QUALITY OF THE ORIGINAL DOCUMENT.

R# 72 DATE 1-31-01 OP EP

CITY OF ALBUQUERQUE

This microimage is certified to be a complete and accurate copy of the original as it appears in the files of the **Planning Department** and was created in the normal course of business.

The photographic process used meets the Basic Microfilm Standards of the National Micrographics Association (MS115-1977)

Richard Sutfin
DIRECTOR

Margaret D. Garcia
NOTARY PUBLIC
Commission expires: 10/22/2001

D C b 12

CITY OF ALBUQUERQUE

D

NOTES:

1. ALL CONDUITS SHALL CONTAIN A HOT-LEG AND NEUTRAL UNLESS INDICATED OTHERWISE.
2. J-BOX ABOVE CEILING FOR CONNECTION TO SALAD BAR LIGHTS. ROUTE CONDUCTORS DOWN THRU CHROME TUBE TO LIGHT FIXTURES.
3. CONNECT ALL EMERGENCY LIGHTS (TYPE B1,S, & X) TO CIRCUIT LA-1.
4. ROUTE CIRCUIT TO DIMMER PANEL 'C' LOCATED IN COSTUME ROOM. DIMMER & PANEL 'C' ARE EXISTING. CIRCUIT INSTALLED BY ELECTRICAL CONTRACTOR.
5. REFER TO SHEET A5 FOR EXACT LOCATION OF LIGHT FIXTURES IN CEILING.
6. OUTLETS, SWITCHES, AND PLATES SHALL BE
   A. STAINLESSAT FRP.
   B. GREY AT MARLITE. SAFETY RECEPTACLES, LEVITON 5362-SGG RECEPTACLE, 80703 SG PLATE.
   C. IVORY AT ALL OTHER AREAS PER SECT. 16140 2C.
   D. CEILING OUTLETS SHALL BE PAINTED TO MATCH CEILING COLOR.
7. INSTALL FIXTURES AND SWITCH (PROVIDED BY OTHERS) IN WALK-IN-BOX. THIS CONTRACTOR SHALL FURNISH AND INSTALL LAMPS AS REQUIRED. REFER TO NOTE 24 ON SHEET E0.
8. ALL LAMPS IN FIXTURES TYPE D AND TYPE G IN SHOWROOM SHALL BE SYLVANIA- SOFT PINK COLOR.
9. MOUNT BOTTOM OF 'G1' FIXTURES 26" ABOVE TABLETOP (TYPICAL).
10. J-BOX FOR SIGN. VERIFY EXACT LOCATION FROM SIGN COMPANY SHOP DRAWINGS.

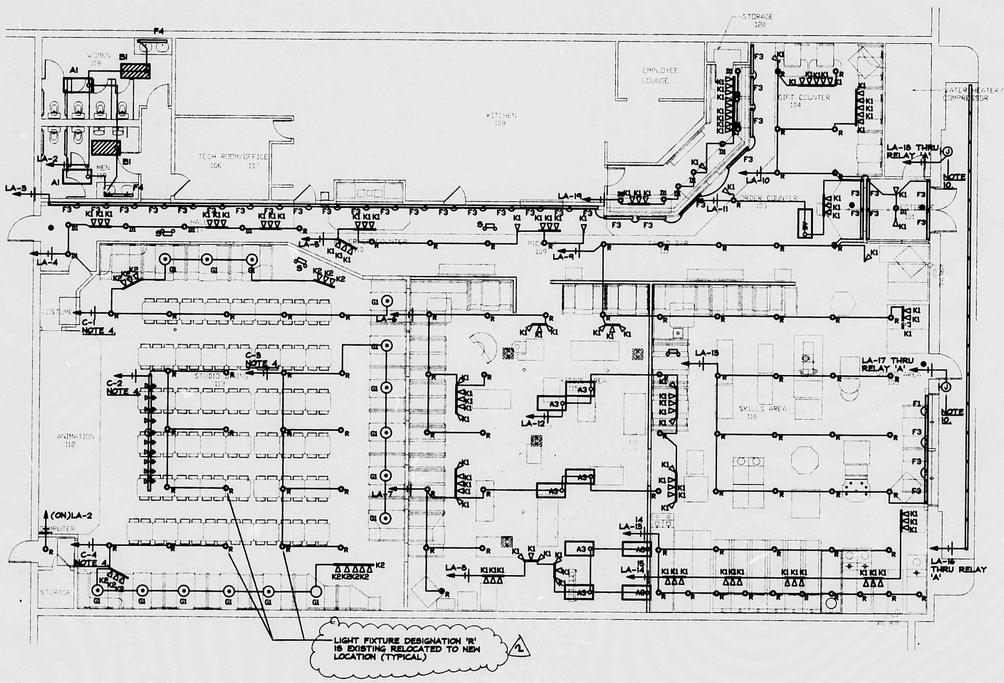

01 FLOOR PLAN – LIGHTING
SCALE: 1/8" = 1'-0"

ALBUQUERQUE BUILDING & SAFETY
OCT 18 1999
U.B.C. PLAN CHECK SECTION

STA # 5241
S. Taub & Associates Inc.
Consulting Engineer • Mechanical / Electrical
13841 Omega Road, Dallas, Texas 75244
972/386-5629

THESE DOCUMENTS ARE THE SOLE PROPERTY OF SHOWBIZ PIZZA TIME, INC. ANY DEPICTING OF THE SPECIFIED PREMISES OR OTHER WORK METHOD CONSTRUCTION OF THIS PROJECT WITHOUT THE EXPRESS WRITTEN PERMISSION OF THE ARCHITECT AND SHOWBIZ PIZZA TIME, INC IS PROHIBITED

C.T. CHANG AIA
100 WEST EULESS BLVD, #103
EULESS, TEXAS 76040

REGISTERED OCT 18 1999 ST. FLORIDA ASSOC.

B&W BURSON AND WILLIAMS
PROJECT ADMINISTRATOR

CHUCK E CHEESE'S PIZZA #332 – ALBUQUERQUE, NEW MEXICO
4418 WYOMING BLVD. NE – ALBUQUERQUE, NEW MEXICO – 87111
CEC ENTERTAINMENT, INC.
4441 WEST AIRPORT FREEWAY
IRVING, TEXAS 75062

FLOOR PLAN – LIGHTING

Date 7/28/99

Revisions
1 09-09-99
2 10-07-99

Project Number 96-180

Sheet Number E1 of 3

CITY OF ALBUQUERQUE
THIS MICROIMAGE IS THE BEST POSSIBLE REPRODUCTION DUE TO THE POOR QUALITY OF THE ORIGINAL DOCUMENT.

R# 79 DATE 1-31-01 OP ESP

CITY OF ALBUQUERQUE
This microimage is certified to be a complete and accurate copy of the original as it appears in the files of the **Planning Department** and was created in the normal course of business.

The photographic process used meets the Basic Microfilm Standards of the National Micrographics Association (MS115-1977)

Richard Scutchfield
DIRECTOR

Margaret D. Garcia
NOTARY PUBLIC
Commission expires: 10/22/2001

D 2 C 20 b 10 12

CITY OF ALBUQUERQUE

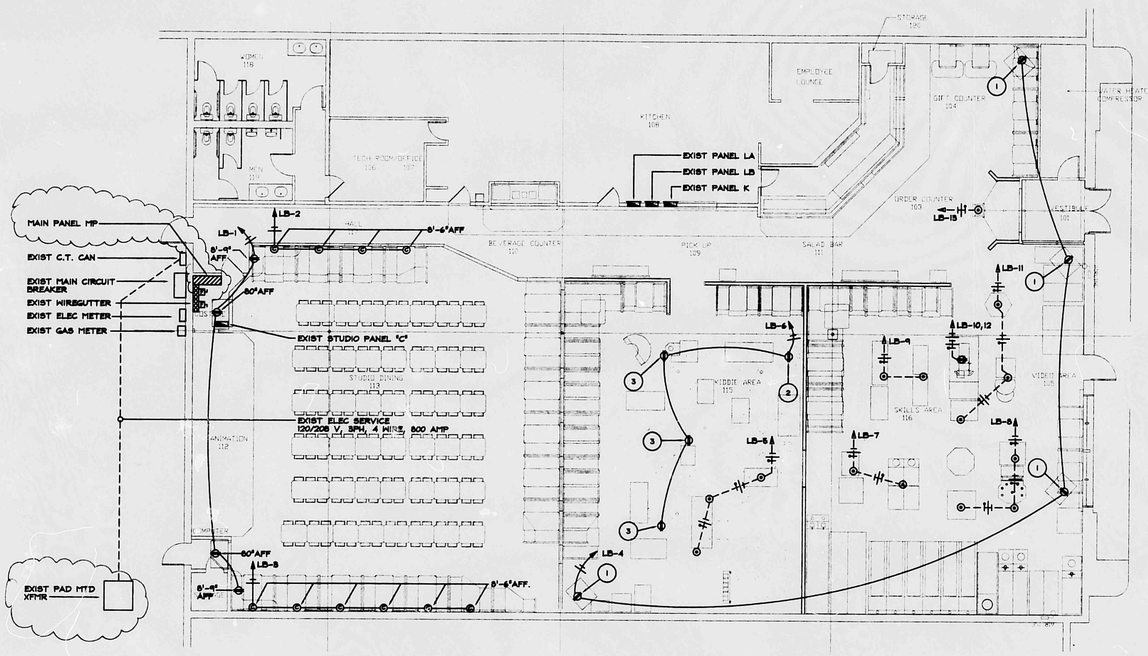

01 FLOOR PLAN – POWER

SCALE: 1/8"=1'-0"

NOTES:

1. ALL CONDUITS SHALL CONTAIN A HOT-LEG AND A NEUTRAL UNLESS INDICATED OTHERWISE.
2. REFER TO SHEET E5 FOR SYMBOL 'KEYED NOTES FOR POWER DISTRIBUTION.'
3. FLOOR BOXES (SYMBOL ⊙) SHALL BE FLUSH MOUNTED, HUBBELL #S-2627 WITH S-3926 BRASS COVER AND WITH #S-3082 CARPET RING.
4. MP, GFI RECEPTACLE ON RTU UNIT.
5. J-BOX IN CEILING FOR CONNECTION TO ELECTRIC SHADES.

CEILING SPEAKER AND SOUND SYSTEM WIRING WILL BE FURNISHED BY THE OWNER AND INSTALLED BY ELECTRICAL CONTRACTOR.

PRIOR TO CUTTING CONCRETE SLAB FOR FLOOR OUTLETS TO GAMES, VERIFY WITH PROJECT MANAGER THAT CONTRACTOR HAS FINAL (REVISED) GAME LAYOUT.

NOTES BY SYMBOL:

(1) 20 AMP 120V DUPLEX CONVENIENCE OUTLET MOUNTED FLUSH IN CEILING FOR MONITOR.
(2) OUTLET FLUSH IN CEILING FOR CONNECTION TO SKY TUBE VENT FANS.
(3) OUTLET ABOVE CEILING MOUNTED HORIZONTALLY FOR CONNECTION TO SKY TUBE SOUND SYSTEM.

ALBUQUERQUE BUILDING & SAFETY
OCT 12 1999
U.B.C. PLAN CHECK SECTION

REGISTERED PROFESSIONAL ENGINEER STATE OF NEW MEXICO NO. 9338
10-8-99

STA # 5241
S. Taub & Associates Inc.
(consulting Engineer • Mechanical / Electrical)
12641 Omega Road, Dallas, Texas 75244
972/386-5629


C.T. CHANG AIA
1010 WEST EULESS BLVD., #103
EULESS, TEXAS 76040

RECEIVED
OCT 08 1999
S. TAUB & ASSOC.

B&W BURSON & WILLIAMS
PROJECT ADMINISTRATOR

CHUCK E CHEESE'S PIZZA #332 – ALBUQUERQUE, NEW MEXICO
418 WYOMING BLVD, NE. – ALBUQUERQUE, NEW MEXICO – 87111
C.E.C. ENTERTAINMENT, INC.
4441 WEST AIRPORT FREEWAY
IRVING, TEXAS 75062

FLOOR PLAN – POWER

Date 7/28/99

Revisions
1 09-09-99
2 10-07-99

Project Number 98-180

Sheet Number E2 of 5

CITY OF ALBUQUERQUE
THIS MICROIMAGE IS THE BEST POSSIBLE REPRODUCTION DUE TO THE POOR QUALITY OF THE ORIGINAL DOCUMENT.

R# 79 DATE 1-31-01 OP EJP

CITY OF ALBUQUERQUE

This microimage is certified to be a complete and accurate copy of the original as it appears in the files of the **Planning Department** and was created in the normal course of business.

The photographic process used meets the Basic Microfilm Standards of the National Micrographics Association (MS115-1977)

Richard Sutfin
DIRECTOR

Margaret D. Marcie
NOTARY PUBLIC

Commission expires: 10/22/2001

D 2 C 20 B 10 12

CITY OF ALBUQUERQUE

C D

BUILDING & SAFETY PLANS 5 of 5

ADD: 4418 WYOMING BLVD. N.E.

DES: REMODEL

LIGHTING FIXTURE SCHEDULE

TYPE	DESCRIPTION	DIFFUSER / LAMPS	REMARKS
A1	RECESSED FLUORESCENT 2x4 TROFFER, STATIC, BAKED WHITE FINISH, 120V BALLAST, ENERGY SAVING LAMPS & BALLAST, 120V,	PRISMATIC ACRYLIC	
	COLUMBIA #_24-4836-FSA12-4E86-120	4-F032/741	
A3	RECESSED FLUORESCENT 2x4 TROFFER, STATIC, BAKED WHITE FINISH, 120V BALLAST, ENERGY SAVING LAMPS & BALLAST, 120V, WITH SPECULAR SILVER 1/2" CUBE PARABOLIC LOUVER	ACRYLIC LOUVER	TYPE 'A3' SAME AS TYPE 'A1' EXCEPT W/ 4-F40T12/850EL BLACK LAMPS
	COLUMBIA #_24-4836-FSPC4-4E86-120	4-F032/741	
B1	SAME AS TYPE 'A1' EXCEPT, EQUIPPED W/ EMERGENCY BATTERY PACK TO DRIVE 1 LAMP FOR 90 MIN (1200 LUM), EMERGENCY SAVING LAMPS & BALLAST, 120V		
	COLUMBIA #_24-4836-FSA12-4E86-120	4-F032/741	
D1	RECESSED FLUORESCENT DOWNLIGHT, NATURAL ALZAK CONE & WHITE TRIM RING, 120V HPF BALLAST	—	
	PRESCOLITE #CFT8S2EB-STP8O2	42W TRIPLE TUBE	
D3	RECESSED INCANDESCENT DOWNLIGHT, NATURAL ALZAK CONE & WHITE TRIM RING, 120V	—	
	PRESCOLITE #FBX-TOTO9	1-100W A21 IF - PINK	
F1	2 FT, 1 LAMP, FLUORESCENT STRIP W/ 110V BALLAST, EMERGENCY SAVING LAMPS & BALLAST	—	
	COLUMBIA #2H2-120-L-120	1-F20T12 GM99, 52 M MAX	
F3	4 FT, 1 LAMP, FLUORESCENT STRIP W/ 110V BALLAST, EMERGENCY SAVING LAMPS & BALLAST	—	FIXTURE TYPE 'F2' SAME AS 'F3' EXCEPT 3 FT LENGTH
	COLUMBIA #2H4-140-LE-120V	1-F40T12 GM99, 45 M MAX	
F4	4 FT, 2 LAMP, FLUORESCENT STRIP W/ 110V BALLAST, EMERGENCY SAVING LAMPS & BALLAST	—	
	COLUMBIA #2S4-240-LE-120V	2-F40T12 GM99	
G1	DECORATIVE FIXTURE, CORD SUSPENDED W/ COPPER FINISH SUSPEND TO 26" ABOVE TOP OF TABLE	—	
	HI-LITES # 408D44 W/ LIGHTOLIER # 756BK CORD ASSEMBLY	1-50W R30-PINK	
K1	TRACK LIGHT FIXTURE ON SINGLE CIRCUIT BLACK TRACK OR MONOPOINT MOUNT AS SHOWN ON PLANS		
	FIXTURE: LIGHTOLIER # 4225BKCC TRACK: LIGHTOLIER # 6000BK SERIES	75W PAR 30 HALOGEN	
K2	TRACK LIGHT FIXTURE ON SINGLE CIRCUIT BLACK TRACK OR MONOPOINT MOUNT AS SHOWN ON PLANS		
	FIXTURE: LIGHTOLIER # 4225BKCC TRACK: LIGHTOLIER # 6000BK SERIES	1-50W R30/FLOOD	
S	EMERGENCY LIGHTING UNIT, LAY-IN TYPE, 2 HEAD, BACK-UP, 120V, UNIVERSAL MOUNT	—	
	PRESCOLITE #EDS-2	2-QUARTZ	
X	EXIT SIGN	RED PLASTIC	
	PRESCOLITE #FEXL3 REN	SUPPLIED	
H3	GROUND MOUNTED VERTICAL FLOOD LIGHT, DARK BRONZE FINISH 120 V BALLAST	FLAT GLASS	MOUNT ON PLUSH 12"Wx12"x12" CONC BASE
	KIM # APL2-TSH4-120-HDS-DBE	1-175 M H	
J1	WALL MOUNTED "WALL PACK" FLOOD LIGHT, GLASS LENS DIE CAST ALUMINUM BODY, DARK BRONZE FINISH, 120 V. BALLAST	PRISMATIC GLASS	REF TO ARCH ELEVATIONS FOR LOCATIONS
	SPAULDING/WHITEWAY # MSRII-M250-120	1-250 M H	
P3	INDOOR WALL MOUNT SCONCE		
	LIGHTOLIER # 4491 BK WITH # 4491 CP	1-PAR 16 H-35 M	

MAIN PANEL MP

120/208 V., 3 PH., 4 WIRE
800 AMP MAIN CIRCUIT BREAKER

CKT. NO	SERVES	CIRCUIT BREAKER: FRAME SIZE	POLE	TRIP RATING	CONDUIT & WIRE	REMARKS
1	PANEL LA	225	3	150	4 #1/0 IN 2"C.	
2	PANEL LB	100	3	100	4 #3 IN 1-1/4"C.	
3	PANEL C	100	3	60	3 #6 IN 1"C.	
4	PANEL K	100	3	100	4 #3 IN 1-1/4"C.	
5	SPARE	100	3	100	—	
6	SPACE		3		—	

PANELBOARD SCHEDULE 'C'

REMARKS	POLES & AMPS	LOAD MATTS			LOAD MATTS	POLES & AMPS	REMARKS
DIMMER LIGHTING	1/20	930	1	2	1800	1/20	DIMMER LIGHTING
DIMMER LIGHTING	1/20	930	3	4	1290	1/20	DIMMER LIGHTING
STAGE PLUGS	1/20	800	5	6	800	1/20	STAGE PLUGS
TV MONITOR	1/20	300	7	8	300	1/20	SOUND SYSTEM
CHUCK E CHEESE	1/20	300	9	10	300	1/20	CHICKEN

LIGHTING LOAD	4,980
POWER LOAD	5,600
TOTAL LOAD	8,580

ALL CIRCUIT BREAKERS SHALL BE RATED FOR SWITCHING DUTY

DESIGNATION	PANEL C
LOCATION	COSTUME ROOM
MOUNTING	SURFACE
VOLTS & PH	208 V., SINGLE PH, 3 WIRE
MAINS	MLO
BUSSING AMPS	60

PANELBOARD SCHEDULE 'K'

REMARKS	POLES & AMPS	LOAD MATTS			LOAD MATTS	POLES & AMPS	REMARKS
WALK IN CONTROL	1/20	500	1	2	1800	1/20	DISHWASHER
OFFICE PLUGS	1/20	800	3	4	800	1/20	COMPUTER OUTLETS
DOUGH ROLLER	1/20	700	5	6	1200	1/20	AIR DRYER
OVEN HOOD	1/20	1000	7	8	1000	1/20	A/C & FAN
KITCHEN ICE TEA	1/20	500	9	10	100	1/20	COFFEE MAKER
WALK IN COMP	1/20	1200	11	12	1000	1/20	PASS THRU HEATER (2)
AIR COMPRESSOR	1/20	1200	13	14	700	1/40	MIXER (HOBART)
BATH ROOM PLUG	1/20	200	15	16	800	1/40	TECH ROOM
TECH ROOM PLUG	1/20	800	17	18	200	1/40	KITCHEN UTILITY PLUG
CARBONATOR	1/20	200	19	20	200	1/20	PLUG BELOW PANELS
SPARE	1/20	---	21	22	400	1/20	BACK BAR-JUICE MACHINE
PIZZA TABLE	1/20	700	23	24	---	1/20	SPARE
ICE CREAM MAKER	1/20	1200	25	26	1800	1/30	COTTON CANDY
ICE MAKER	1/20	1500	27	28	---	1/20	SPARE
SPARE	1/20	---	29	30	---	1/20	SPARE
SPARE	1/20	---	31	32	---	1/20	SPARE
SPARE	1/20	---	33	34	---	1/20	SPARE
SPARE	1/20	---	35	36	---	1/20	SPARE
SPARE	1/20	---	37	38	---	1/20	SPARE
SPARE	1/20	---	39	40	---	1/20	SPARE
SPARE	1/20	---	41	42	---	1/20	SPARE

LIGHTING LOAD	---
POWER LOAD	20,300
TOTAL LOAD	20,300

ALL CIRCUIT BREAKERS SHALL BE RATED FOR SWITCHING DUTY

DESIGNATION	PANEL K
LOCATION	KITCHEN
MOUNTING	PLUSH
VOLTS & PH	120/208 V., 3 PH., 4 WIRE
MAINS	MLO
BUSSING AMPS	100

PANELBOARD SCHEDULE 'LA'

REMARKS	POLES & AMPS	LOAD MATTS			LOAD MATTS	POLES & AMPS	REMARKS
EMERGENCY LIGHTING & EXITS	1/20	800	1	2	900	1/20	TOILET LIGHTING
HALL LIGHTING	1/20	1500	3	4	1275	1/20	HALL LIGHTING
BEVERAGE COUNTER LIGHTING	1/20	1500	5	6	1500	1/20	KIDDIE AREA LIGHTING
KIDDIE AREA LIGHTING	1/20	1295	7	8	1575	1/20	KIDDIE AREA LIGHTING
SKILLS AREA LIGHTING	1/20	1525	9	10	1425	1/20	GIFTY COUNTER LIGHTING
ORDER COUNTER LIGHTING	1/20	925	11	12	1210	1/20	KIDDIE AREA LIGHTING
SKILLS AREA LIGHTING	1/20	1200	13	14	1500	1/40	SKILLS AREA LIGHTING
SKILLS AREA LIGHTING	1/20	1125	15	16	1600	1/40	AWNING
SIGN	1/20	1000	17	18	1000	1/40	SIGN
STORAGE LIGHTING	1/20	1500	19	20	---	1/20	SPARE
SPARE	1/20	---	21	22	---	1/20	SPARE
HALL LIGHTS	1/20	1000	23	24	500	1/20	EMERGENCY LIGHTS
PLANO LOUNGE LIGHTS	1/20	1000	25	26	1000	1/20	FANTASY FLOOD LIGHTS
GENERAL STORE LIGHTS	1/20	1000	27	28	1000	1/20	STAGE GUTTER LIGHTS
STAGE GUTTER LIGHTS	1/20	1000	29	30	500	1/20	WEST CASH REGISTER
KITCHEN & TECH RM LIGHTS	1/20	1000	31	32	1000	1/20	KITCHEN LIGHTS
EAST CASH REGISTER	1/20	800	33	34	800	1/20	ICE TEA & SODA MACH
LIONS LIGHTS	1/20	1000	35	36	800	1/20	HALL PLUG
TIME CLOCK	1/20	100	37	38	100	1/20	TIME CLOCK
SPARE	1/20	---	39	40	---	1/20	SPARE
SPARE	1/20	---	41	42	---	1/20	SPARE

LIGHTING LOAD	52,775
POWER LOAD	3,400
TOTAL LOAD	56,175

ALL CIRCUIT BREAKERS SHALL BE RATED FOR SWITCHING DUTY

DESIGNATION	PANEL LA
LOCATION	KITCHEN
MOUNTING	PLUSH
VOLTS & PH	120/208 V., 3 PH., 4 WIRE
MAINS	MLO
BUSSING AMPS	225

PANELBOARD SCHEDULE 'LB'

REMARKS	POLES & AMPS	LOAD MATTS			LOAD MATTS	POLES & AMPS	REMARKS
MONITORS	1/20	600	1	2	800	1/20	DECOR
DECOR	1/20	700	3	4	600	1/20	MONITORS
GAMES FLOOR BOXES	1/20	800	5	6	1000	1/20	SKY CRAWL
GAMES FLOOR BOXES	1/30	800	7	8	800	1/20	GAMES FLOOR BOXES
GAMES FLOOR BOXES	1/20	800	9	10	800	1/20	GAMES FLOOR BOXES
GAMES FLOOR BOXES	1/20	800	11	12	800	1/20	GAMES FLOOR BOXES
KID CHECK	1/20	180	13	14	700	1/40	STEP LIGHT & PLUG
GAMES PLUGS MOTOR CYCLE	1/20	1200	15	16	1000	1/40	GAMES PLUGS CHICKEN+BALLOON
GAMES PLUGS TURBO	1/20	1200	17	18	---	1/40	SPARE
SPARE	1/20	---	19	20	---	1/20	SPARE
SPARE	1/20	---	21	22	500	1/20	SUNDAE BAR PLUG+VACUUM PLUG
EXTERIOR SIGN & HALL PLUG	1/20	1180	23	24	200	1/20	REAR COMPUTER PLUG
ENTRANCE PLUGS NEAR KING KM	1/20	600	25	26	800	1/20	STAGE PLUGS
STAGE PLUGS	1/20	600	27	28	800	1/20	STAGE PLUGS
RAISED GAME PLUGS	1/20	800	29	30	800	1/20	RAISED GAME PLUGS OUT RUN
RAISED GAME PLUG	1/20	800	31	32	800	1/20	RAISED GAME PLUGS KIDDIE RM
FRONT COMPUTER PLUG	1/20	800	33	34	800	1/20	RAISED GAME PLUG
GAME PLUGS COVE	1/20	1000	35	36	1000	1/20	GAME PLUGS GENERAL STORE
GAME PLUGS (VACUUM)	1/20	1000	37	38	700	1/20	TREE PLUGS
TREE PLUGS	1/20	700	39	40	---	1/20	SPARE
SPARE	1/20	---	41	42	---	1/20	SPARE

LIGHTING LOAD	---
POWER LOAD	27,660
TOTAL LOAD	27,660

ALL CIRCUIT BREAKERS SHALL BE RATED FOR SWITCHING DUTY

DESIGNATION	PANEL LB
LOCATION	KITCHEN
MOUNTING	PLUSH
VOLTS & PH	120/208 V., 3 PH., 4 WIRE
MAINS	MLO
BUSSING AMPS	100

ALL LAMPS SHALL BE 'SYLVANIA'; NO SUBSTITUTE
GENERAL CONTRACTOR TO PROVIDE ALL LAMPS IN ALL FIXTURES

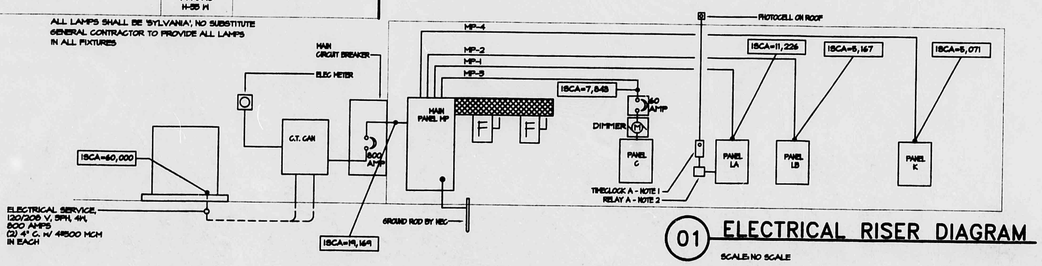

01 ELECTRICAL RISER DIAGRAM
SCALE: NO SCALE

ELECTRICAL LOAD SUMMARY

LARGEST LOAD ON RECORD IS 184.2 KH RECORD BY PSNM ON JULY, 1998
184.2 KH X 1.25 = 202 KVA (AVERAGE)
200.0 KVA X 1.25 = 250 KVA (PEAK)
28% OF LIGHTING = 10 KVA
NEW GRAND TOTAL = 260 KVA
260,000 / 208 = 723 AMPS
ELECTRICAL SERVICE IS 800 AMPS

NOTES:
1. TIMECLOCK A: SHALL BE SEVEN DAY WITH SKIP-A-DAY & 24 HOUR DIAL FOR 'OFF' SIGNAL TO RELAY.
2. RELAY A:
4 POLE MECHANICALLY HELD ELECTRICALLY OPERATED, 20 AMP WITH PHOTO-CELL 'ON' SIGNAL AND TIMECLOCK 'OFF' SIGNAL
ASCO #917202C01 WITH ACCESSORY 847 IN NEMA 1 ENCLOSURE.

ISCA=60,000 SYMBOL INDICATES INSTANTANEOUS SHORT CIRCUIT AMPS AVAILABLE.

ALBUQUERQUE BUILDING & SAFETY
OCT 12 1999
U.P.C. PLAN CHECK SECTION

STATE OF NEW MEXICO — NO. 13398 — REGISTERED PROFESSIONAL ENGINEER
James M. Pavlik
10-8-99

STA # 5241
S. Toub & Associates Inc.
Consulting Engineers - Mechanical / Electrical
13841 Omega Road, Dallas, Texas 75244
972/386-5878

CHUCK E. CHEESE'S PIZZA #332 – ALBUQUERQUE, NEW MEXICO
448 WYOMING BLVD, NE – ALBUQUERQUE, NEW MEXICO – 87111
C.E.C. ENTERTAINMENT, INC.
4441 WEST AIRPORT FREEWAY
IRVING, TEXAS 75062

SCHEDULES & RISERS

Date 7/28/99

Revisions
1 09-09-99
2 10-07-99

Project Number 98-180

Sheet Number E3 OF 3

THESE DOCUMENTS ARE THE SOLE PROPERTY OF BURSON-WILLIAMS AND SHALL NOT BE USED IN WHOLE OR IN PART FOR ANY PURPOSE WITHOUT THE EXPRESS WRITTEN CONSENT OF THE ARCHITECT AND SHALL NOT BE LOANED, COPIED OR REPRODUCED IN ANY FORM OR MANNER WHATSOEVER.

B&W BURSON WILLIAMS
PROJECT ADMINISTRATOR

4415 S. Wyoming Blvd NE
ADDRESS
Remodel
CLASS OF WORK
DESCRIPTION
APR 5 - 2000
SUBMITTED BY
DATE
11 CARDS
PICKED UP BY
DATE
DUPLICATE CARDS
RECEIVED BY
DATE

CITY OF ALBUQUERQUE
THIS MICROIMAGE IS THE BEST POSSIBLE REPRODUCTION DUE TO THE POOR QUALITY OF THE ORIGINAL DOCUMENT.

R# 779 DATE 1-3101 OP ESP
CITY OF ALBUQUERQUE
This microimage is certified to be a complete and accurate copy of the original as it appears in the files of the Planning Department and was created in the normal course of business.
The photographic process used meets the Basic Microfilm Standards of the National Micrographics Association (MS115-1977)
Richard Sutfin
DIRECTOR
Margaret D. Garcia
NOTARY PUBLIC
Commission expires: 10/22/2001

D 2 C 20 b 10 12

CITY OF ALBUQUERQUE

C D